


T. 2 S., R. 1 W., W. M.

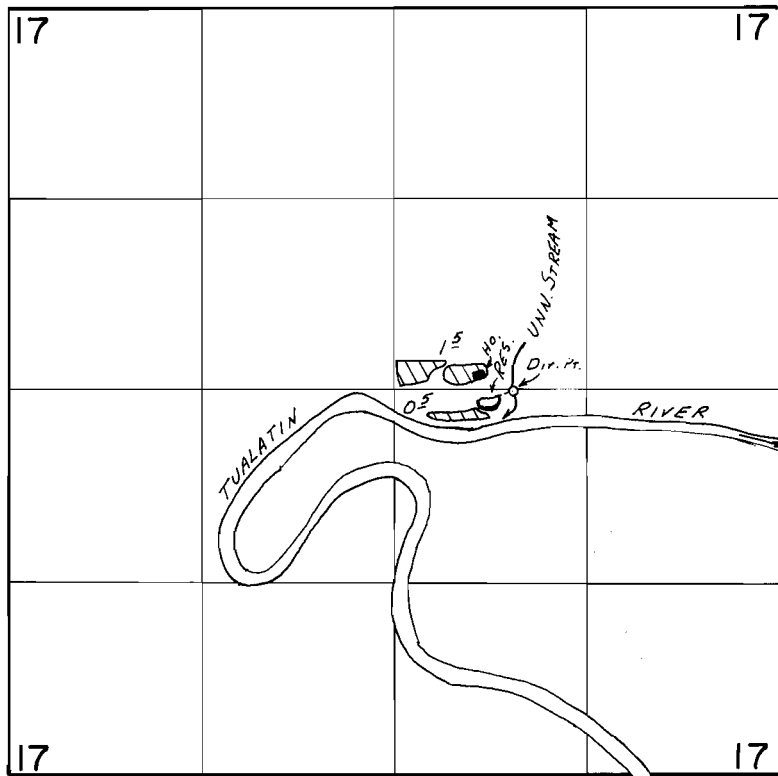

Div. Pt. Loc.: 20'S. & 810'E. FROM CENTER 1/4 COR. SEC. 17

SCALE: 1" = 1320'

FINAL PROOF SURVEY UNDER

R-57732 R-7675

Application No. 57733... Permit No. 43310.....

IN NAME OF

.....EARL F. ROBISON.....

Surveyed Sept. 26, 1984, by B.W. BISHOP.....