


T.16S.,R.6W.,W.M

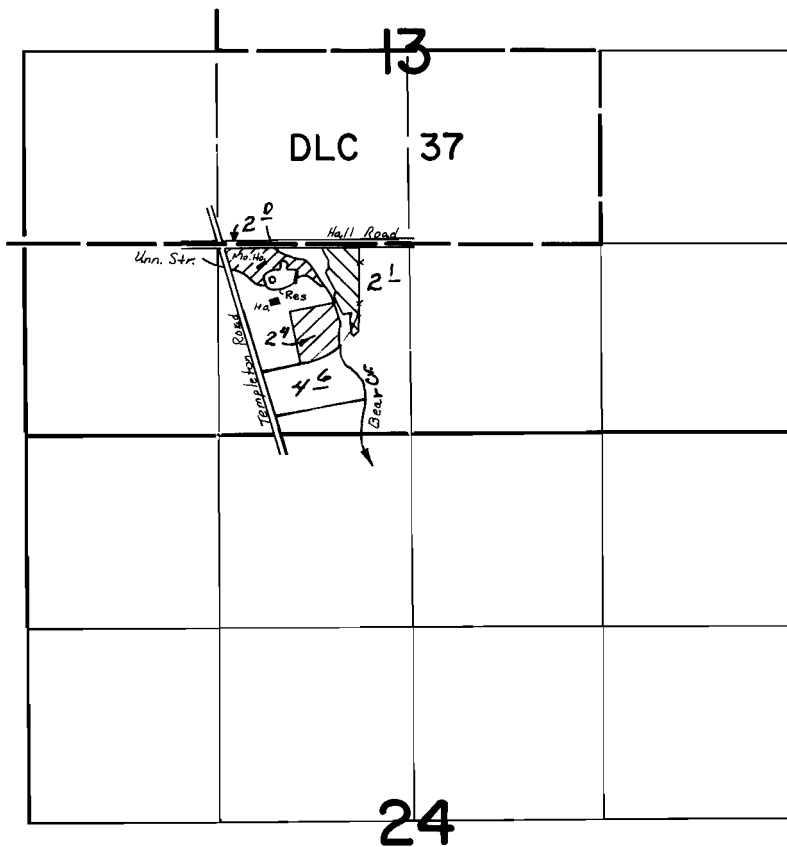

Res. Loc: 1080 ft. N and 780 ft. W from S $\frac{1}{4}$ Cor. Sec. 13



- Primary
- Supplemental (Stored Water Only)
- Supplemental

FINAL PROOF SURVEY

UNDER

Application No. R-57709 Permit No. R-7740
57710 43709
 IN NAME OF

JAMES A. HILL

Surveyed Aug. 5 1982, by L. M. TOLL