


T. 3 S. R. 5 W. WM.

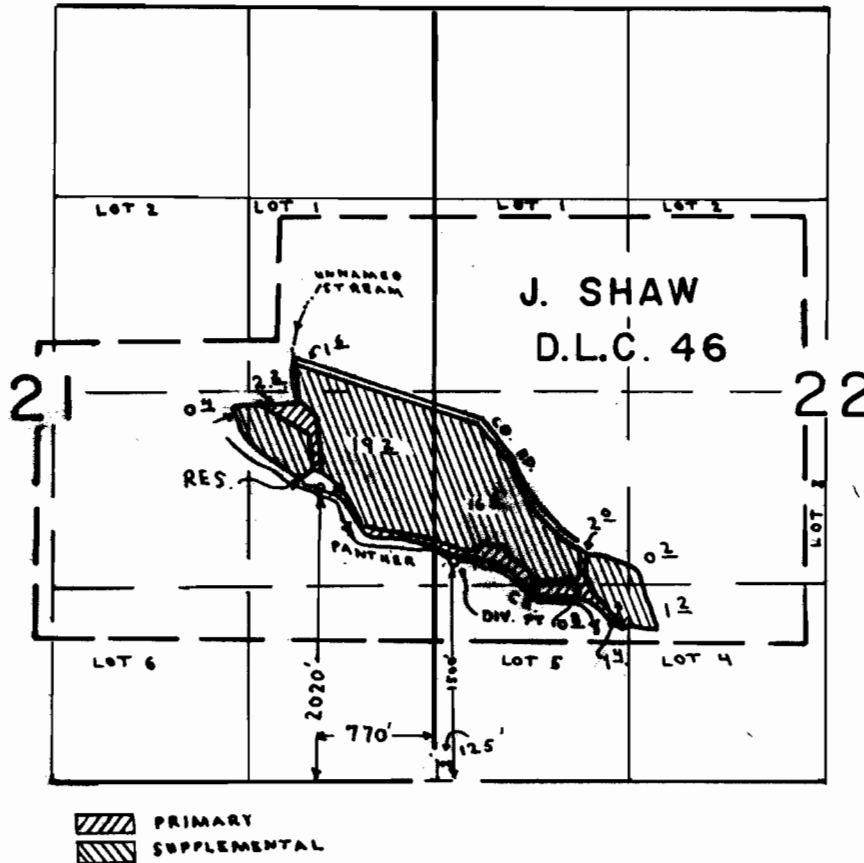

FINAL PROOF SURVEY
UNDER

R 58927 R 8152
Application No. 58928 Permit No. 44950
IN NAME OF
RICHARD VON
Surveyed AUG 24 1984, by P. PAGTER