



T. 3 S. R. 5 W. WM.

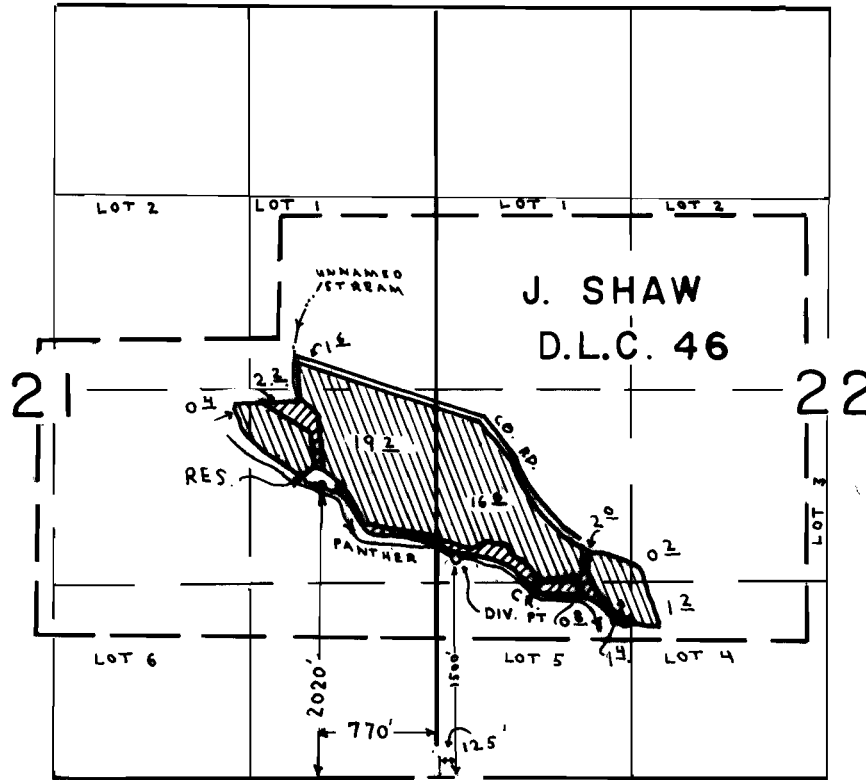

 PRIMARY  
 SUPPLEMENTAL

  
 SCALE  
 4" = 1 MILE

**FINAL PROOF SURVEY**  
UNDER

R 58927                      R 8152  
 Application No. 58928 Permit No. 44950

IN NAME OF

RICHARD VON

Surveyed AUG 24 1984, by P. PAGTER