


T.7S.,R.45E.,W.M

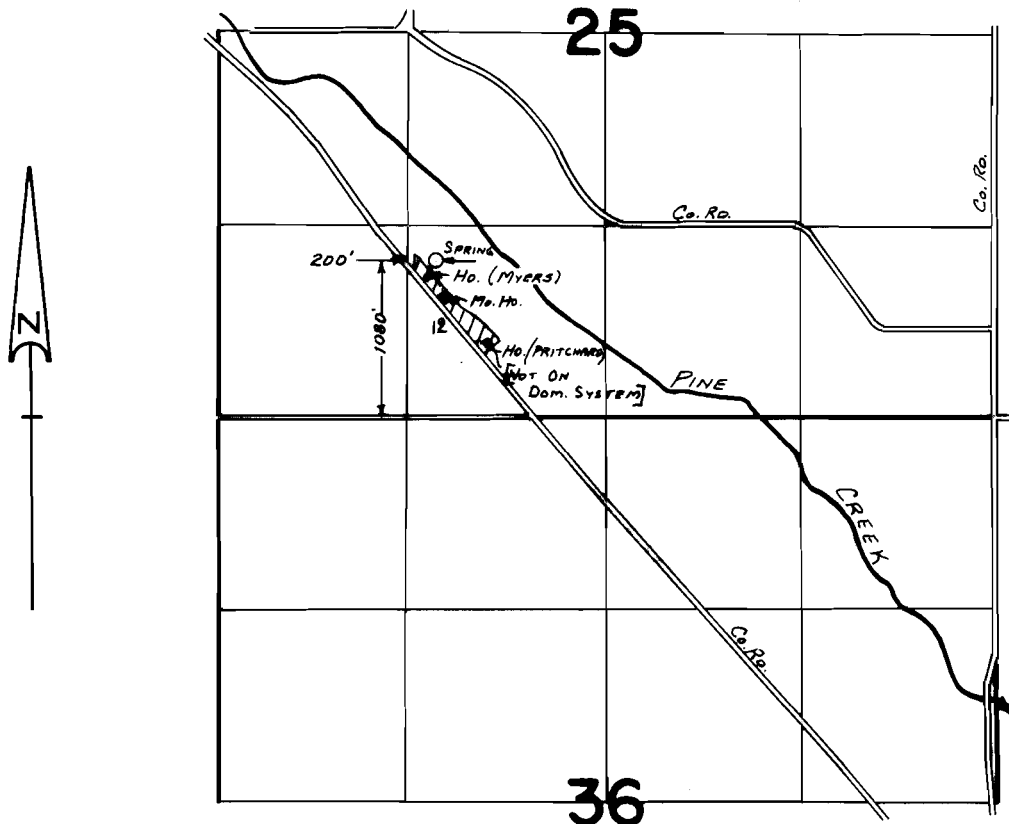

SCALE : 1" = 1320'

FINAL PROOF SURVEY UNDER

Application No. 56425 Permit No. 42337.....
IN NAME OF

HENSLEY PRITCHARD.....

Surveyed Aug. 14 1985., by L. M. TOLL.....