

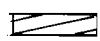


# T. 37 S., R. 6 W., W.M.

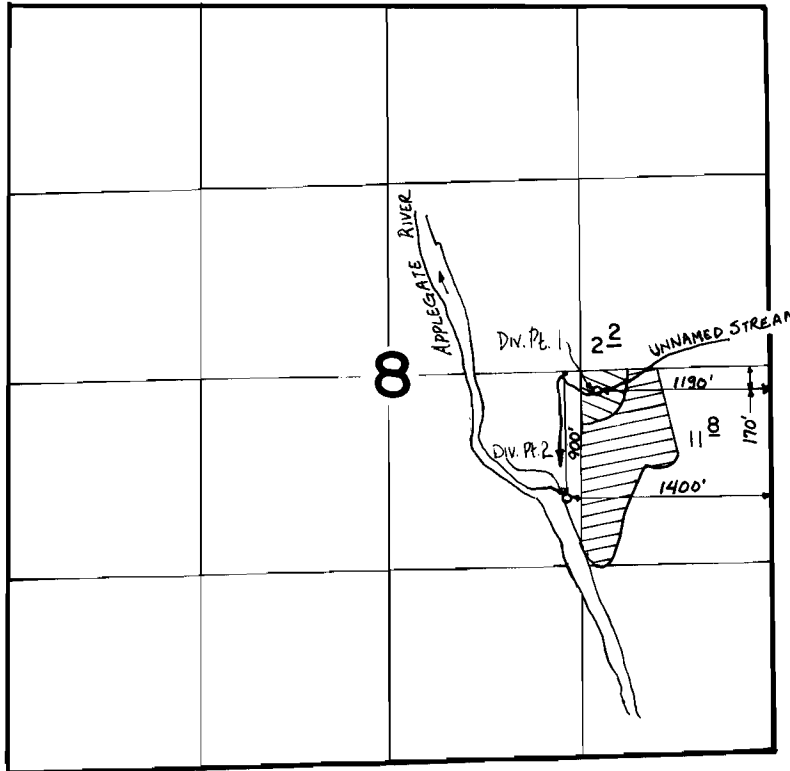

Primary from Div. Pt. 2

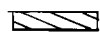

Primary from Div. Pt. 1, Supplemental  
from Div. Pt. 2

## FINAL PROOF SURVEY UNDER

Application No. 56339. Permit No. 42365.....  
IN NAME OF

**CARLA VAN DOORN**

Surveyed OCT. 18, 1983., by B.S. JAMES.....