


T. 26 S., R. 3 W., W.M.

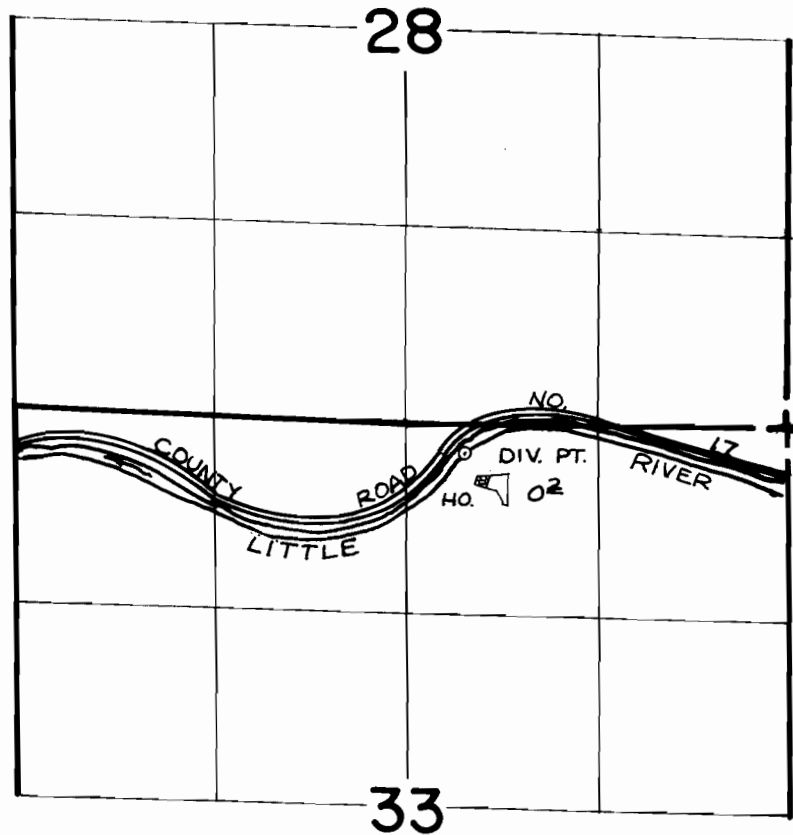

DIV. PT. IS LOCATED 200' S. & 2230' W. OF NE SEC. COR. SEC. 33

SCALE: 4" = 1 mile

- IRRIGATION PRIOR TO "C" DATE
- IRRIGATION AFTER "C" DATE

FINAL PROOF SURVEY UNDER

Application No. 57534.. Permit No. 43359.....
IN NAME OF

.....MARK K. & JERRY LYNN BUECHLEY.

Surveyed AUG...1.. 1984., by ..D...CLARK.....