


T.16S.,R.5E.,W.M.

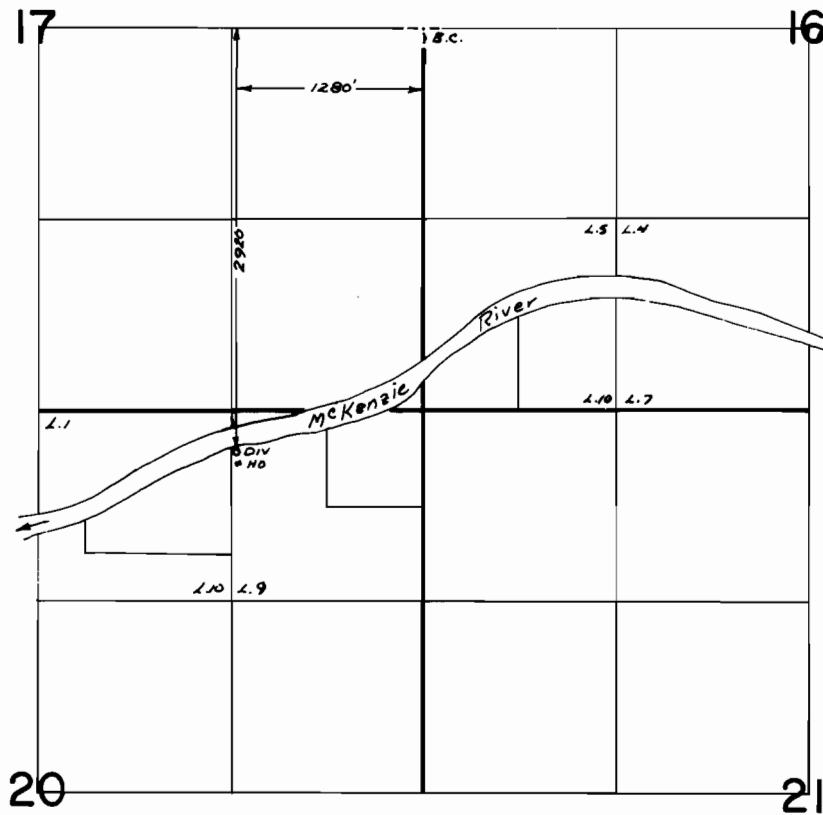

FINAL PROOF SURVEY
UNDER

Application No. 59676 Permit No. 44886
IN NAME OF

.....*ROBERT & JANE BROWN*.....

Surveyed Aug. 18. 1981., by S. C. BROWN.....