RECEIVED
AUG 4 1981
WATER RESOURCES DEPT
SALEM, OREGON

Application No. 62114
Permit No. 46349

MAP OF SURVEY OF LOTS 1 and 2, BLOCK 4 "IDLEREST"

SITUATED IN SEC. 4 T.34S. R.7E. W.M.
KLAMATH COUNTY, ORE.

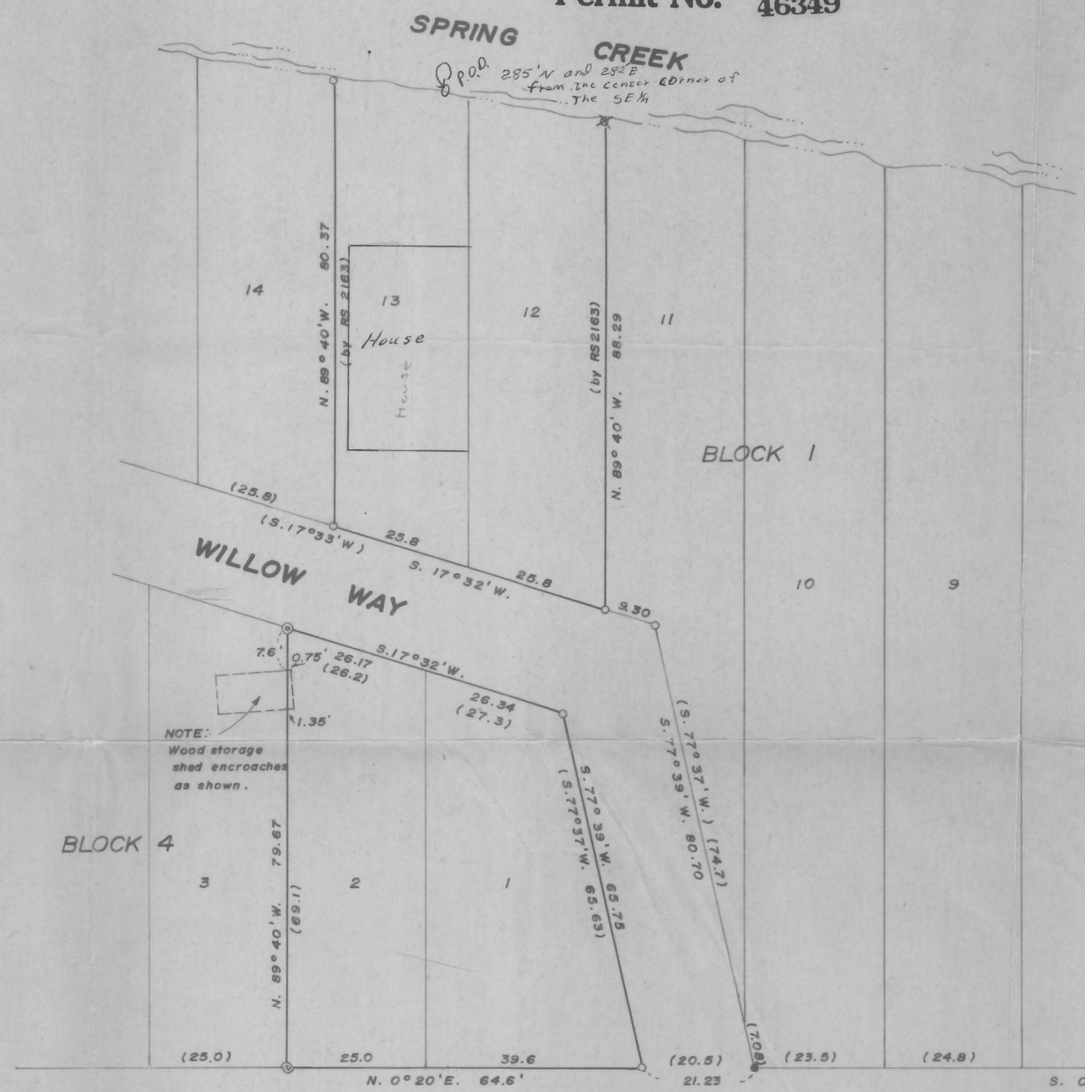

NORTH
SCALE 1" = 20

LEGEND

RECORD DISTANCES AND BEARINGS SHOWN IN PARENTHESIS.

BASIS OF BEARINGS = RS 117 & 2163 centerline of Glendale St.

- ○ Found 1/2" rebar
- ● Found 3/4" pipe
- ⊠ Found 1 1/4" pipe
- ◎ Set 5/8"x 30" rebar with alum. cap in concrete

SCALE 1" = 20'

RECEIVED
JAN 18 1982
WATER RESOURCES DEPT.
SALEM, OREGON

REGISTERED PROFESSIONAL LAND SURVEYOR
Dale A Cross
OREGON JULY 13, 1973 DALE A. CROSS 993

SURVEY FOR DON D. SUTPHIN
LOTS 1 & 2 BLK. 4 "IDLEREST"
KLAMATH COUNTY, ORE.

DATE: 4 - 12 - 80 | PROJECT NO.: 40

ALPHA-OMEGA
LAND SURVEYING SERVICES
4027 Sturdivant Ave.
Klamath Falls, Oregon 97601
(503) 884-5336