


T. 2 N., R. 12 E., W.M.

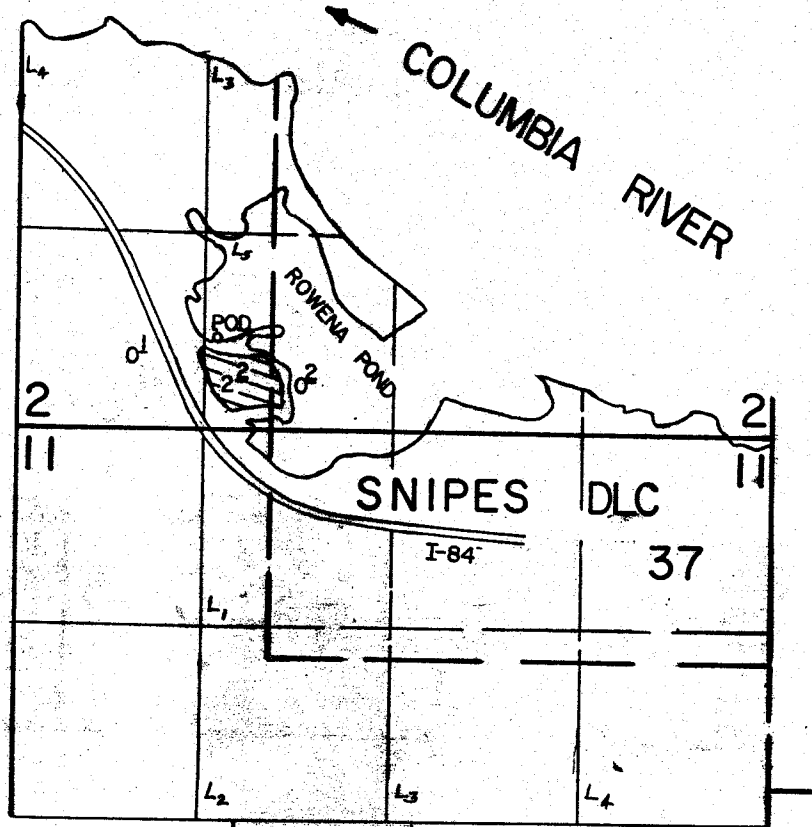

P.O.D. Loc. : 610' N. & 1230' W. from S. 1/4 Cor., Sec. 2.

Scale : 1" = 1320'

FINAL PROOF SURVEY
UNDER

Application No. 67991 Permit No. 48309
IN NAME OF

OREGON STATE PARKS & RECREATION DIV.

Surveyed JUNE 9 1988, by T. WARREN

41065-179-235 D
T.M.W.