


# T. 28 S., R. 14 W., W.M.

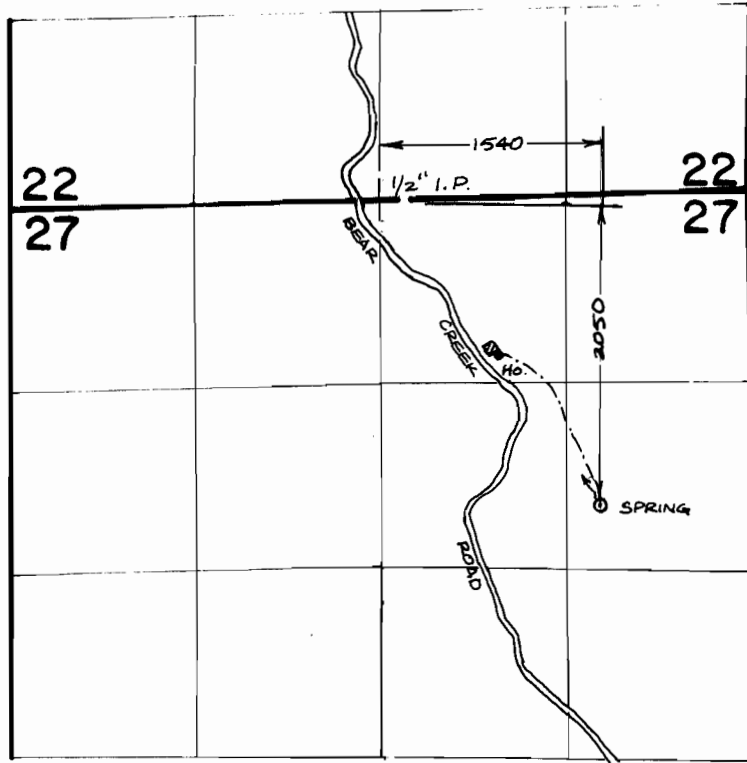

SCALE : 4" = 1 MILE

## FINAL PROOF SURVEY UNDER

Application No. 67957... Permit No. ...48325...  
IN NAME OF

CHARLES CROW MITCHELL, III

Surveyed OCT...24., 19.85., by J.M.SCHMORDE.