


T. 28 S., R. 14 W., W.M.

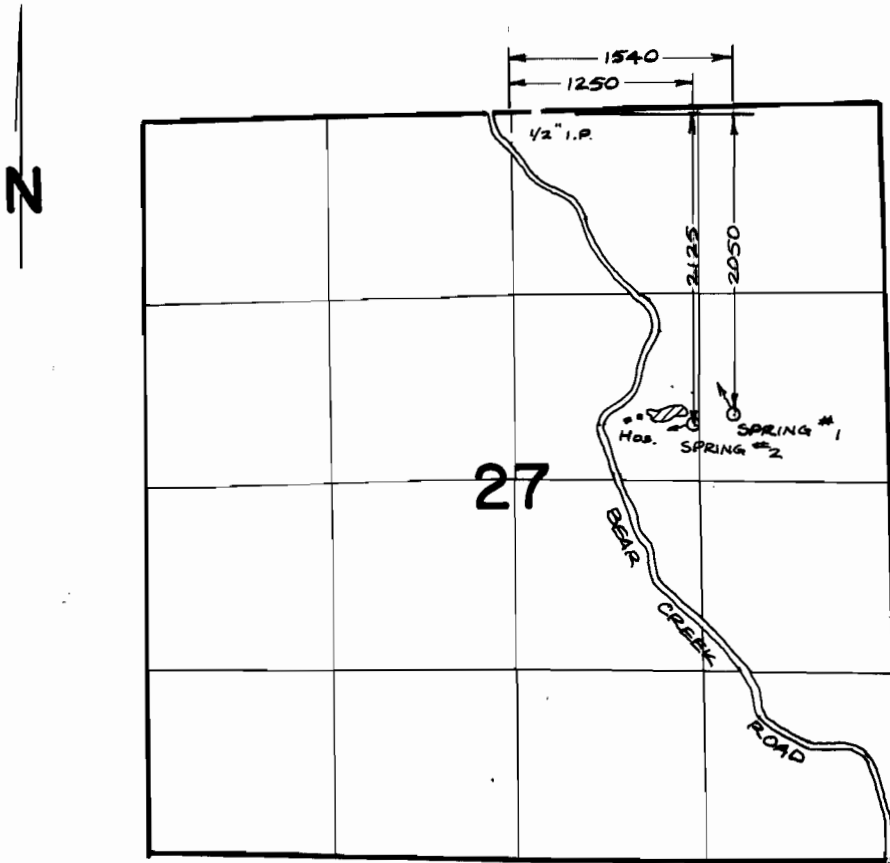

SCALE : 4" = 1 MILE

FINAL PROOF SURVEY UNDER

Application No. 67,336. Permit No. 48,406...
IN NAME OF

HAROLD D. CLEETON & JENNIFER CLEETON

Surveyed OCT. 24, 1985, by J.M. SCHMORDE