


YAMHILL COUNTY

RECEIVED

FEB 15 1985
WATER RESOURCES DEPT.
SALEM, OREGON

Application No. 68277
Permit No. 49247

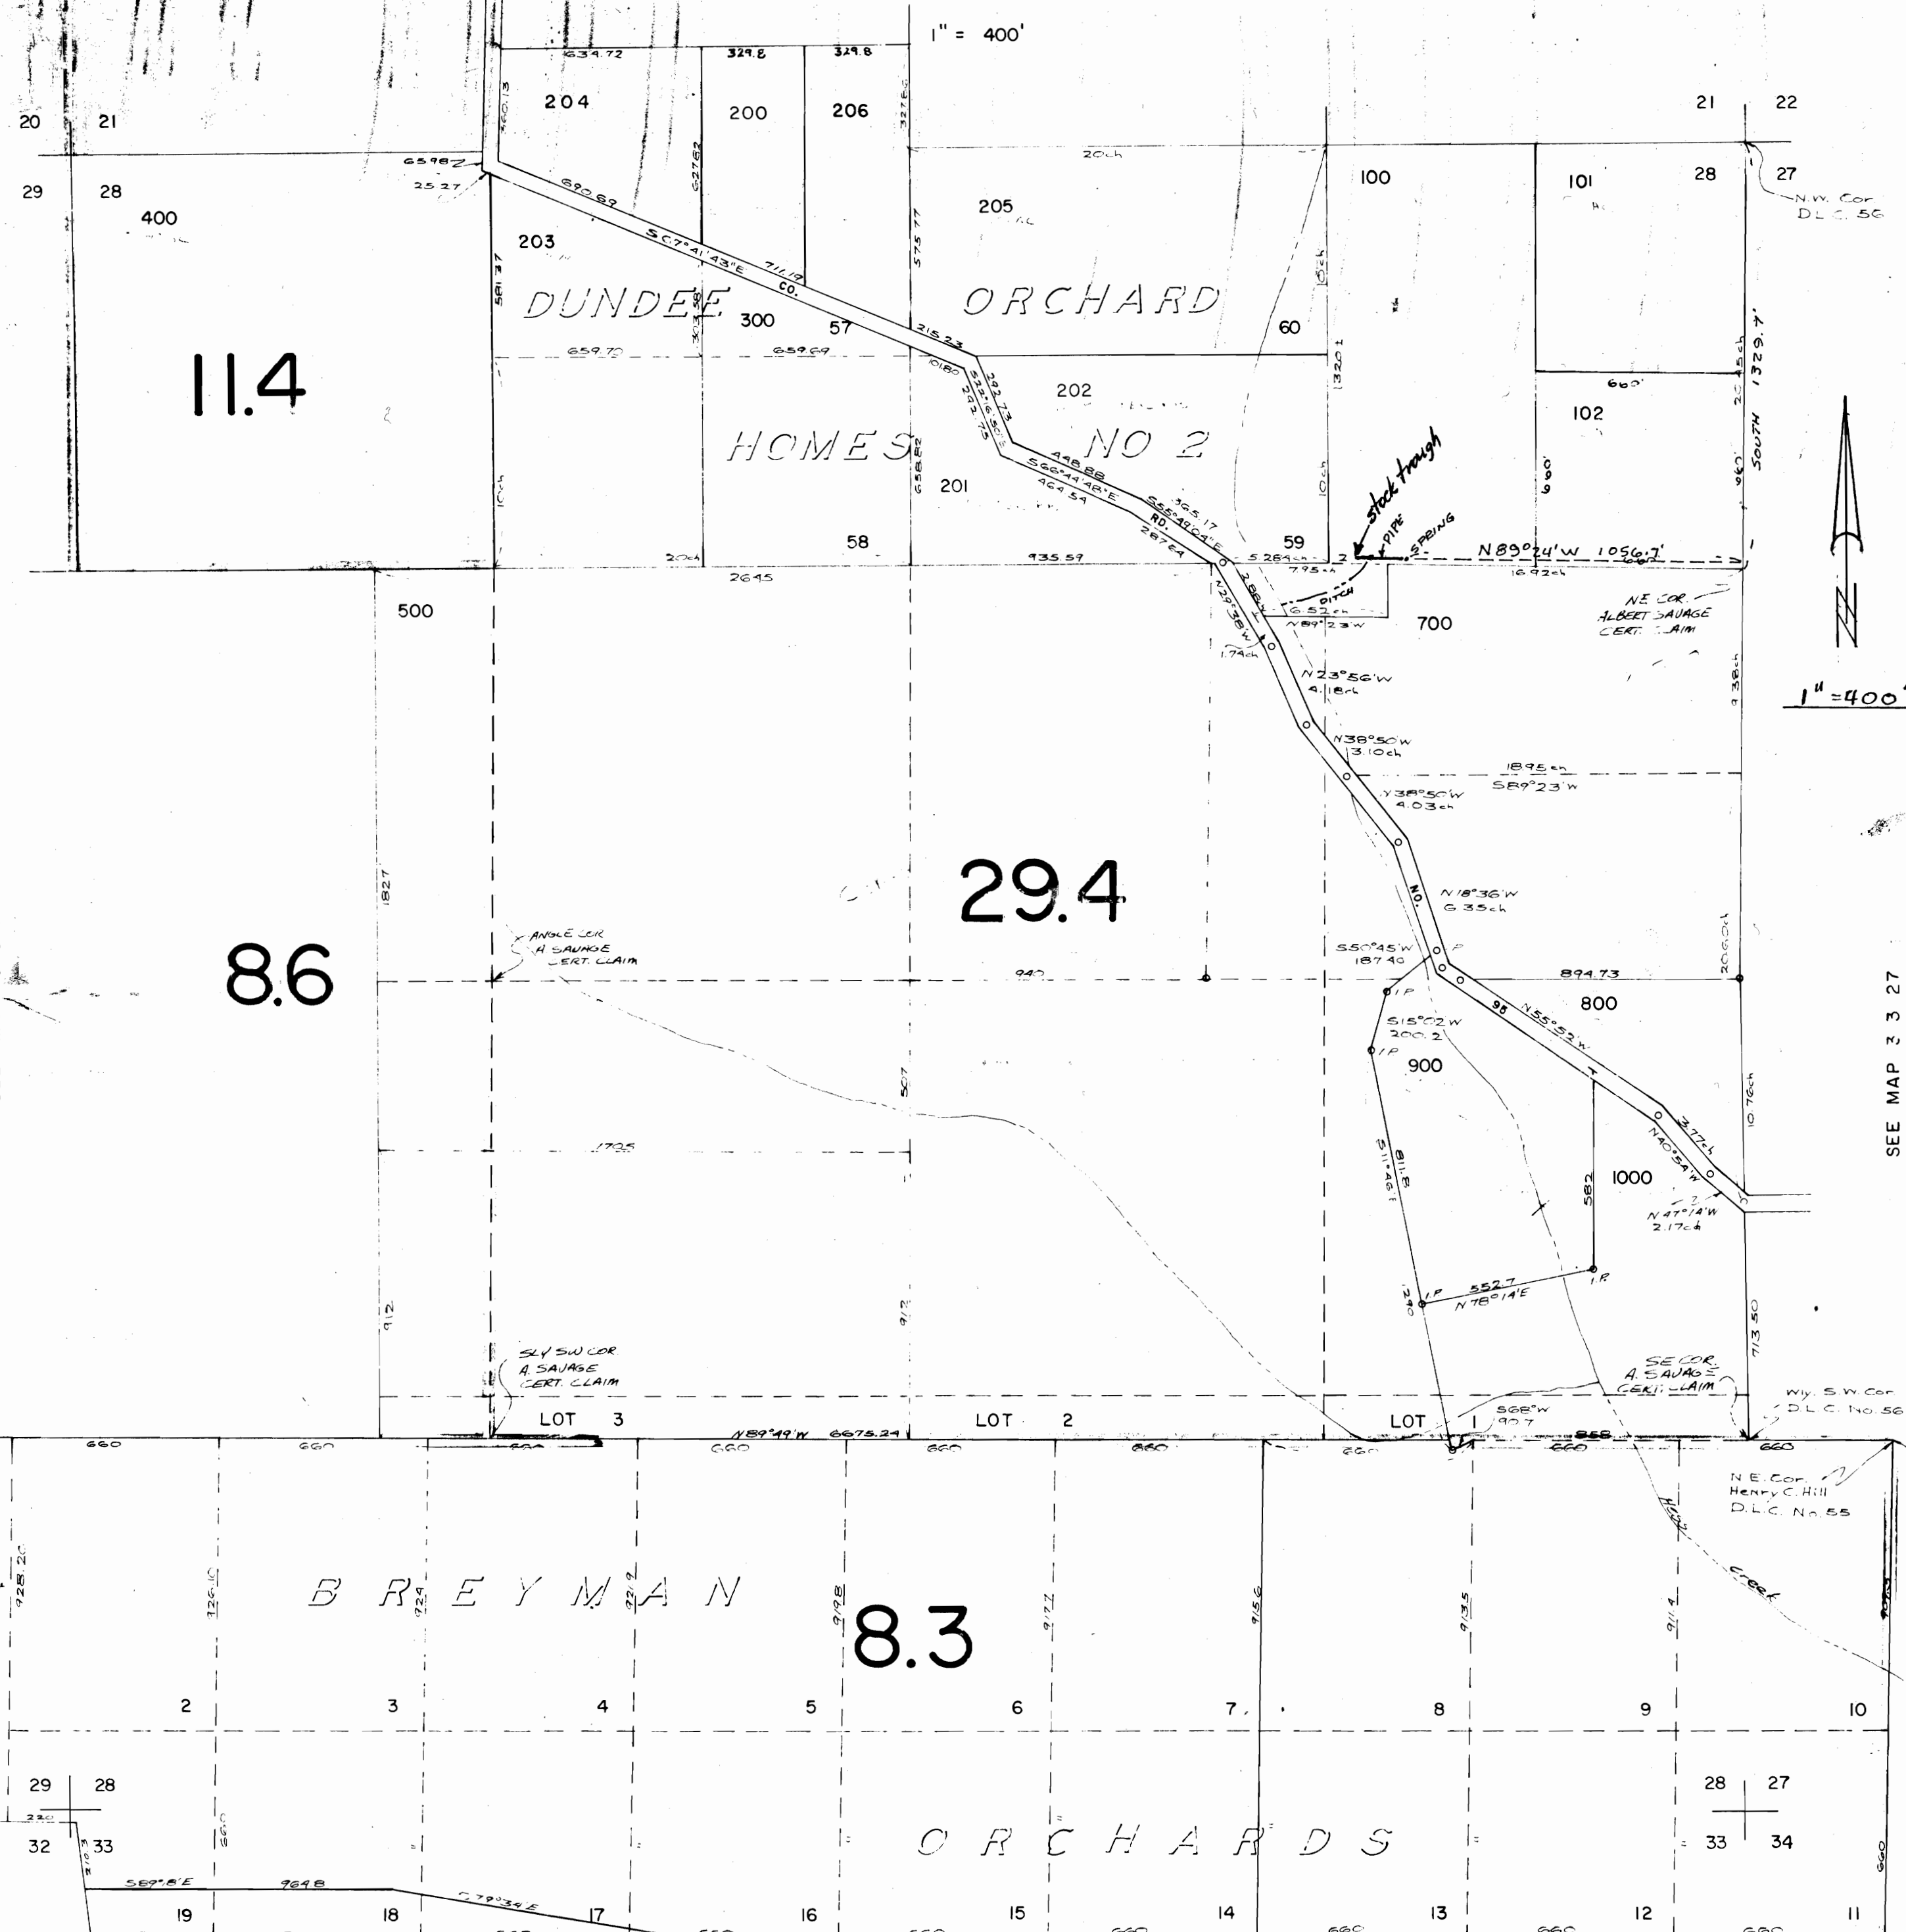


11.4

29.4

8.6

8.3

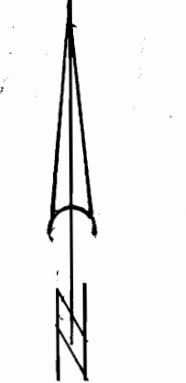

SEE MAP 3 3 29

SEE MAP 3 3 27