


scale 5.28 inches = 1 mile

T 15S R 25E Sec 23 NE 1/4 of NW 1/4

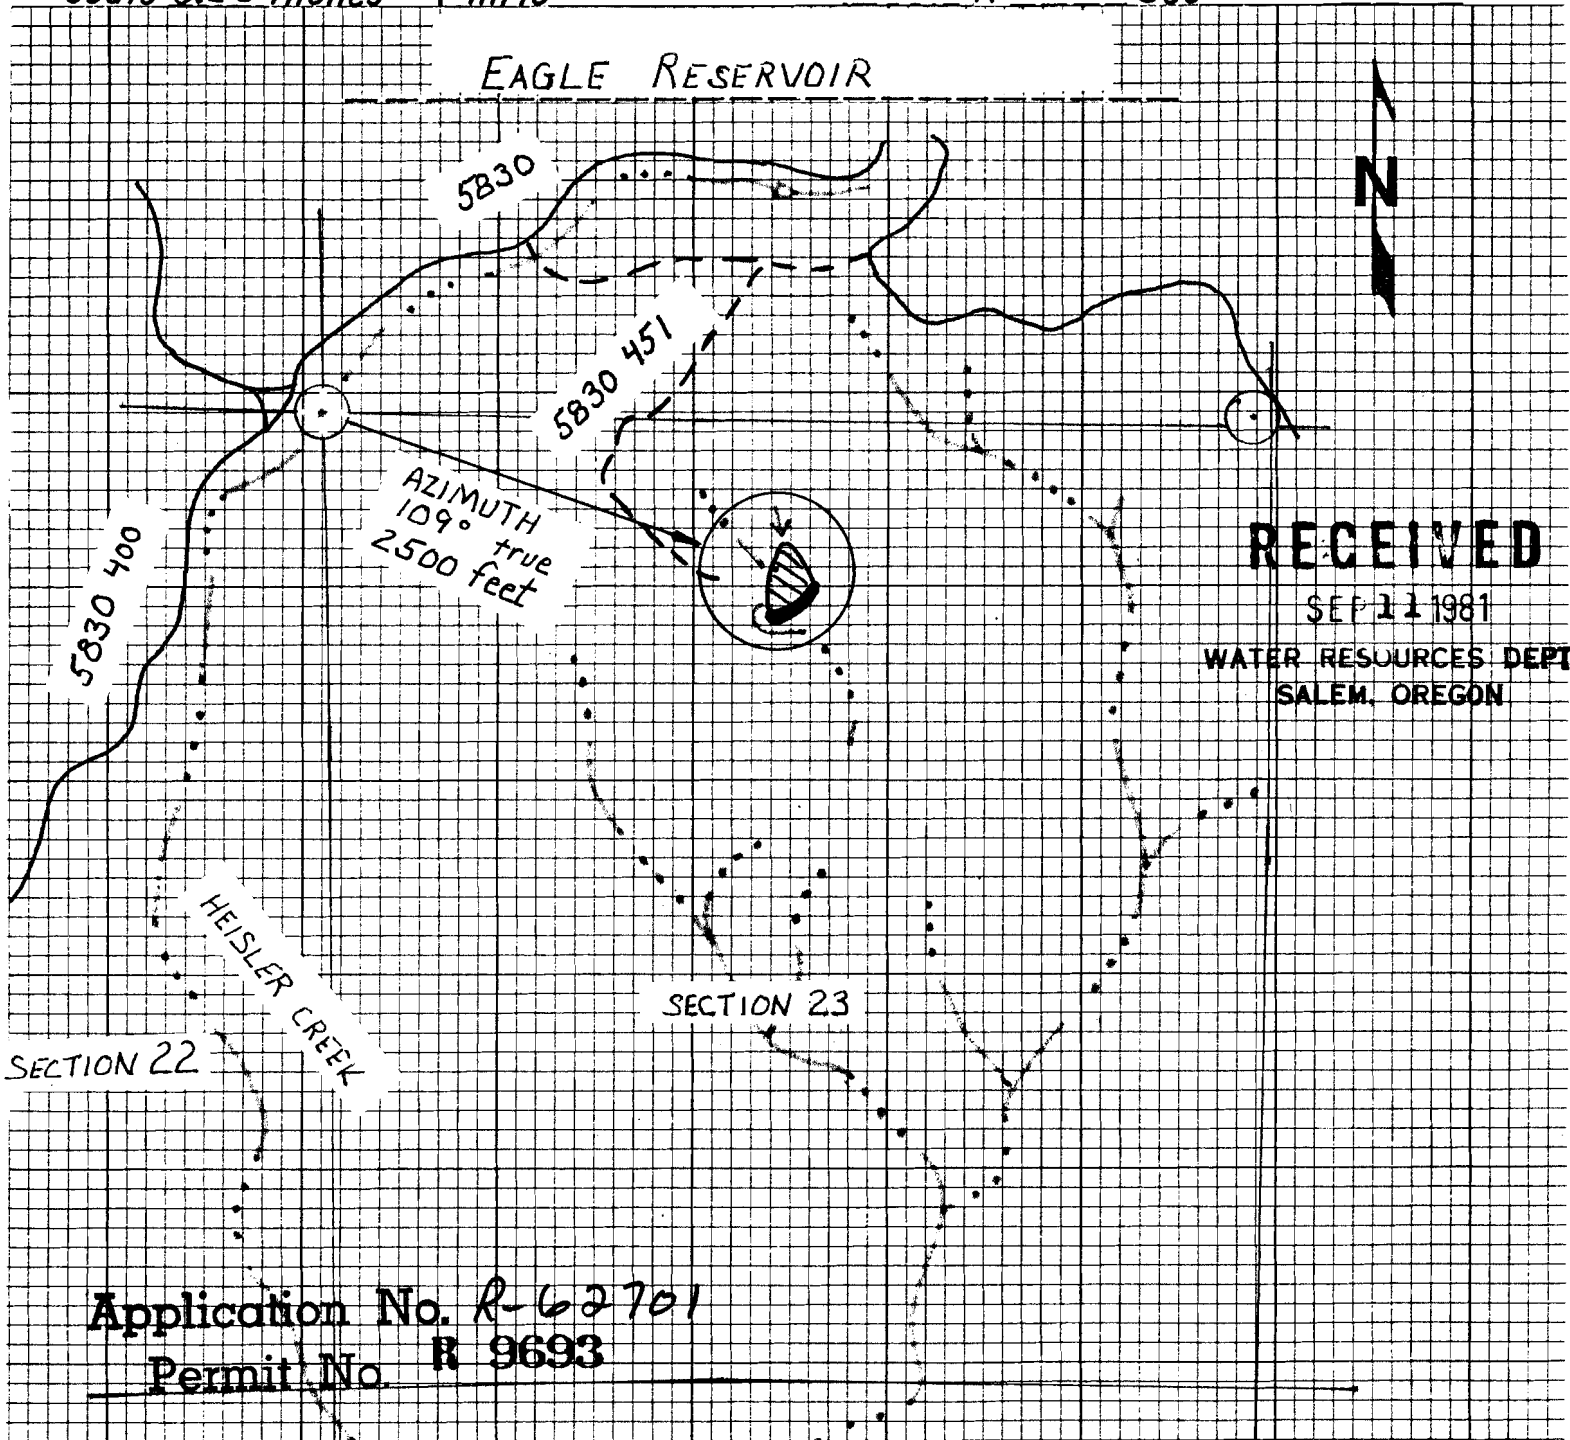

KEY

- RESERVOIR NOT TO SCALE
- INTERMITTENT STREAM CHANNEL
- ROAD
- - - OLD DIRT ROAD

○ SECTION CORNER
SEARCHED FOR NOT FOUND

field work by

J. Fitzpatrick & J. Kuhn

date

8-21-80

platted by

J. Fitzpatrick