


BUCK RESERVOIR

Application No. R-62702
Permit No. R 9694

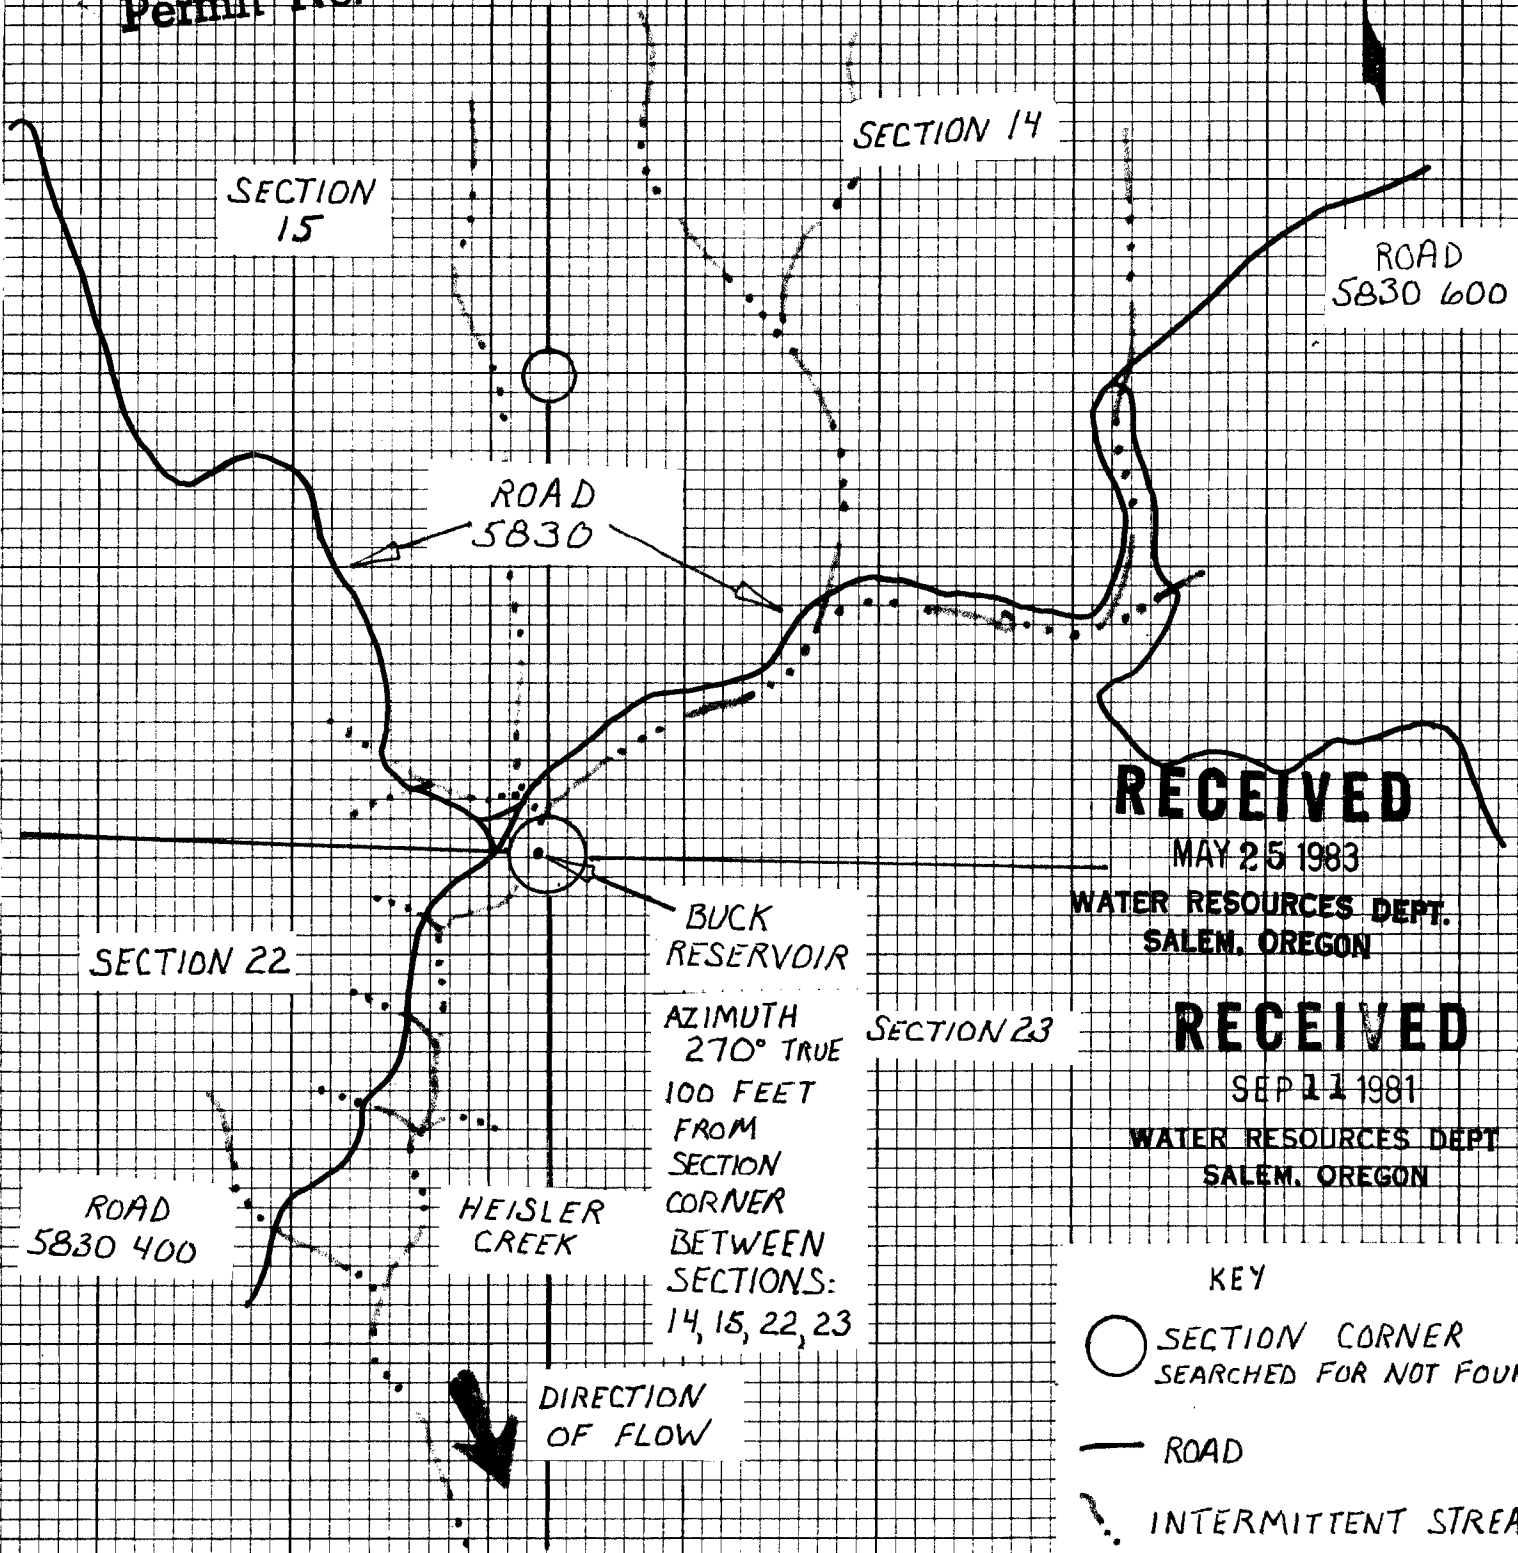

field work by

J. Fitzpatrick & J. Kuhn

date 8-22-80

platted by

J. Fitzpatrick