


R-9696

scale 5.28 inches = 1 mile

T 16S R 26E Sec 26 NW 1/4 NE 1/4

PORCUPINE RESERVOIR

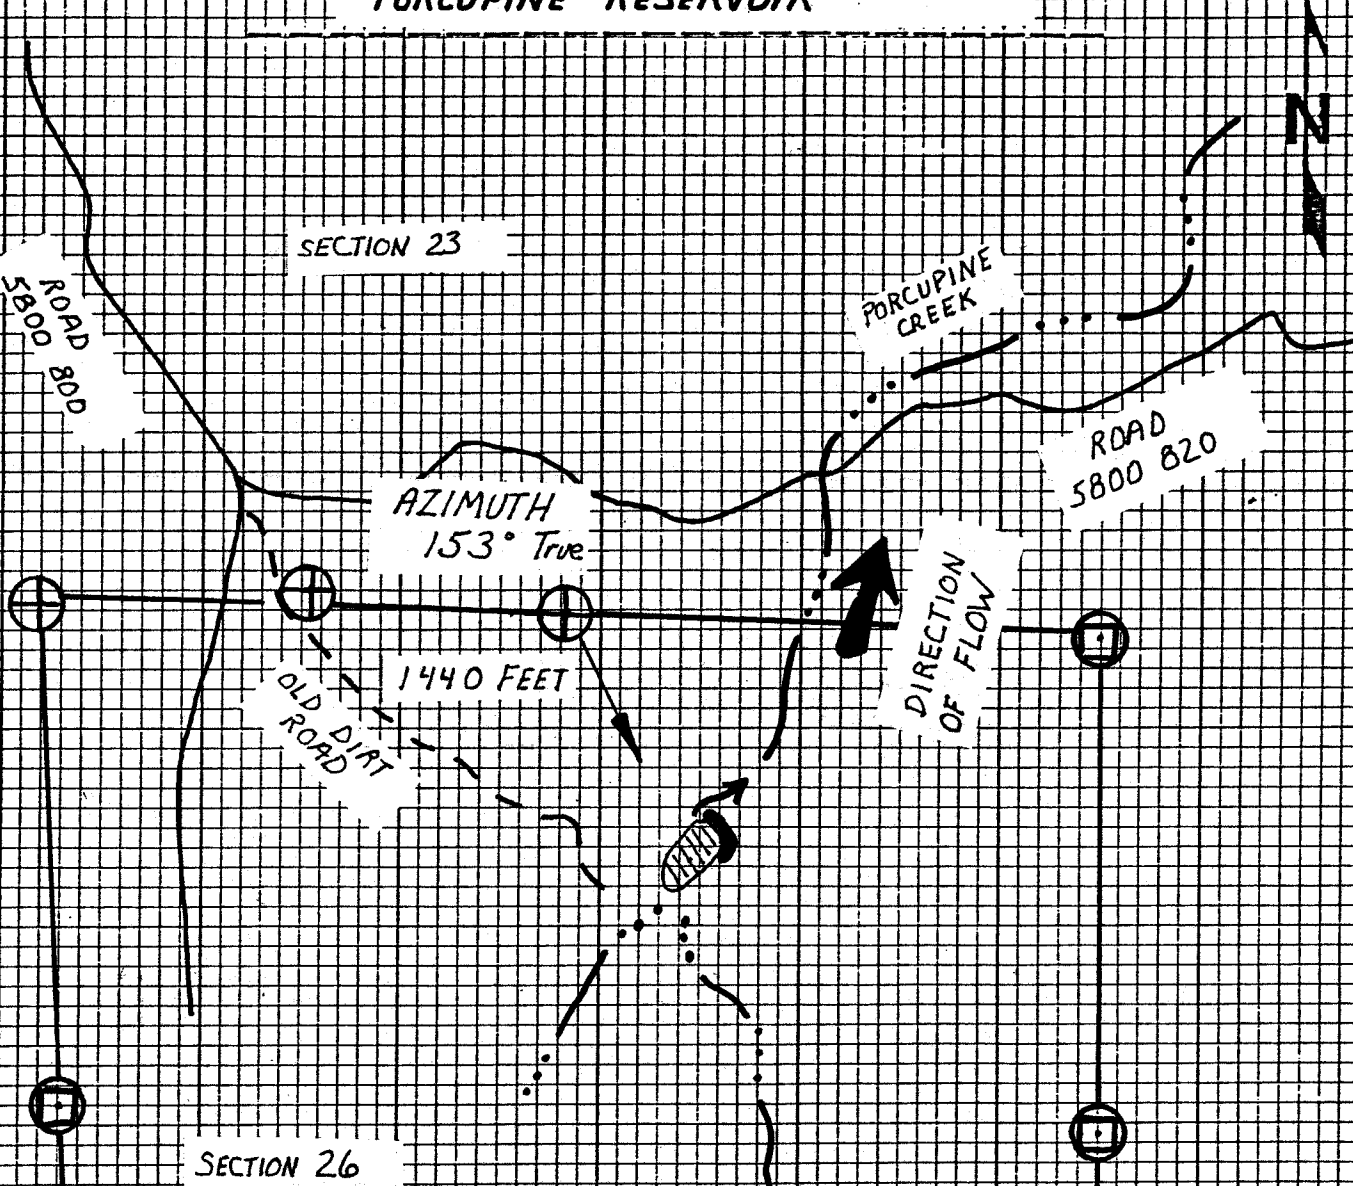

Application No. R-62704
Permit No. R 9696

RECEIVED

SEP 11 1981

WATER RESOURCES DEPT
SALEM, OREGON

KEY

RESERVOIR NOT TO SCALE

----- INTERMITTENT STREAM

- - - OLD DIRT ROAD

— SYSTEM ROAD

⊕ } SECTION CORNERS
⊞ } MONUMENTED

field work by J. Fitzpatrick + J. Huhn date 7-22-80
platted by J. Fitzpatrick