

scale 5.28 inches = 1 mile


T 15 S R 25 E Sec 9 SE 1/4 of SW 1/4

BOX SPRING

Application No. R-62706
R-62707

Permit No. 48426
R 9697

SECTION 9

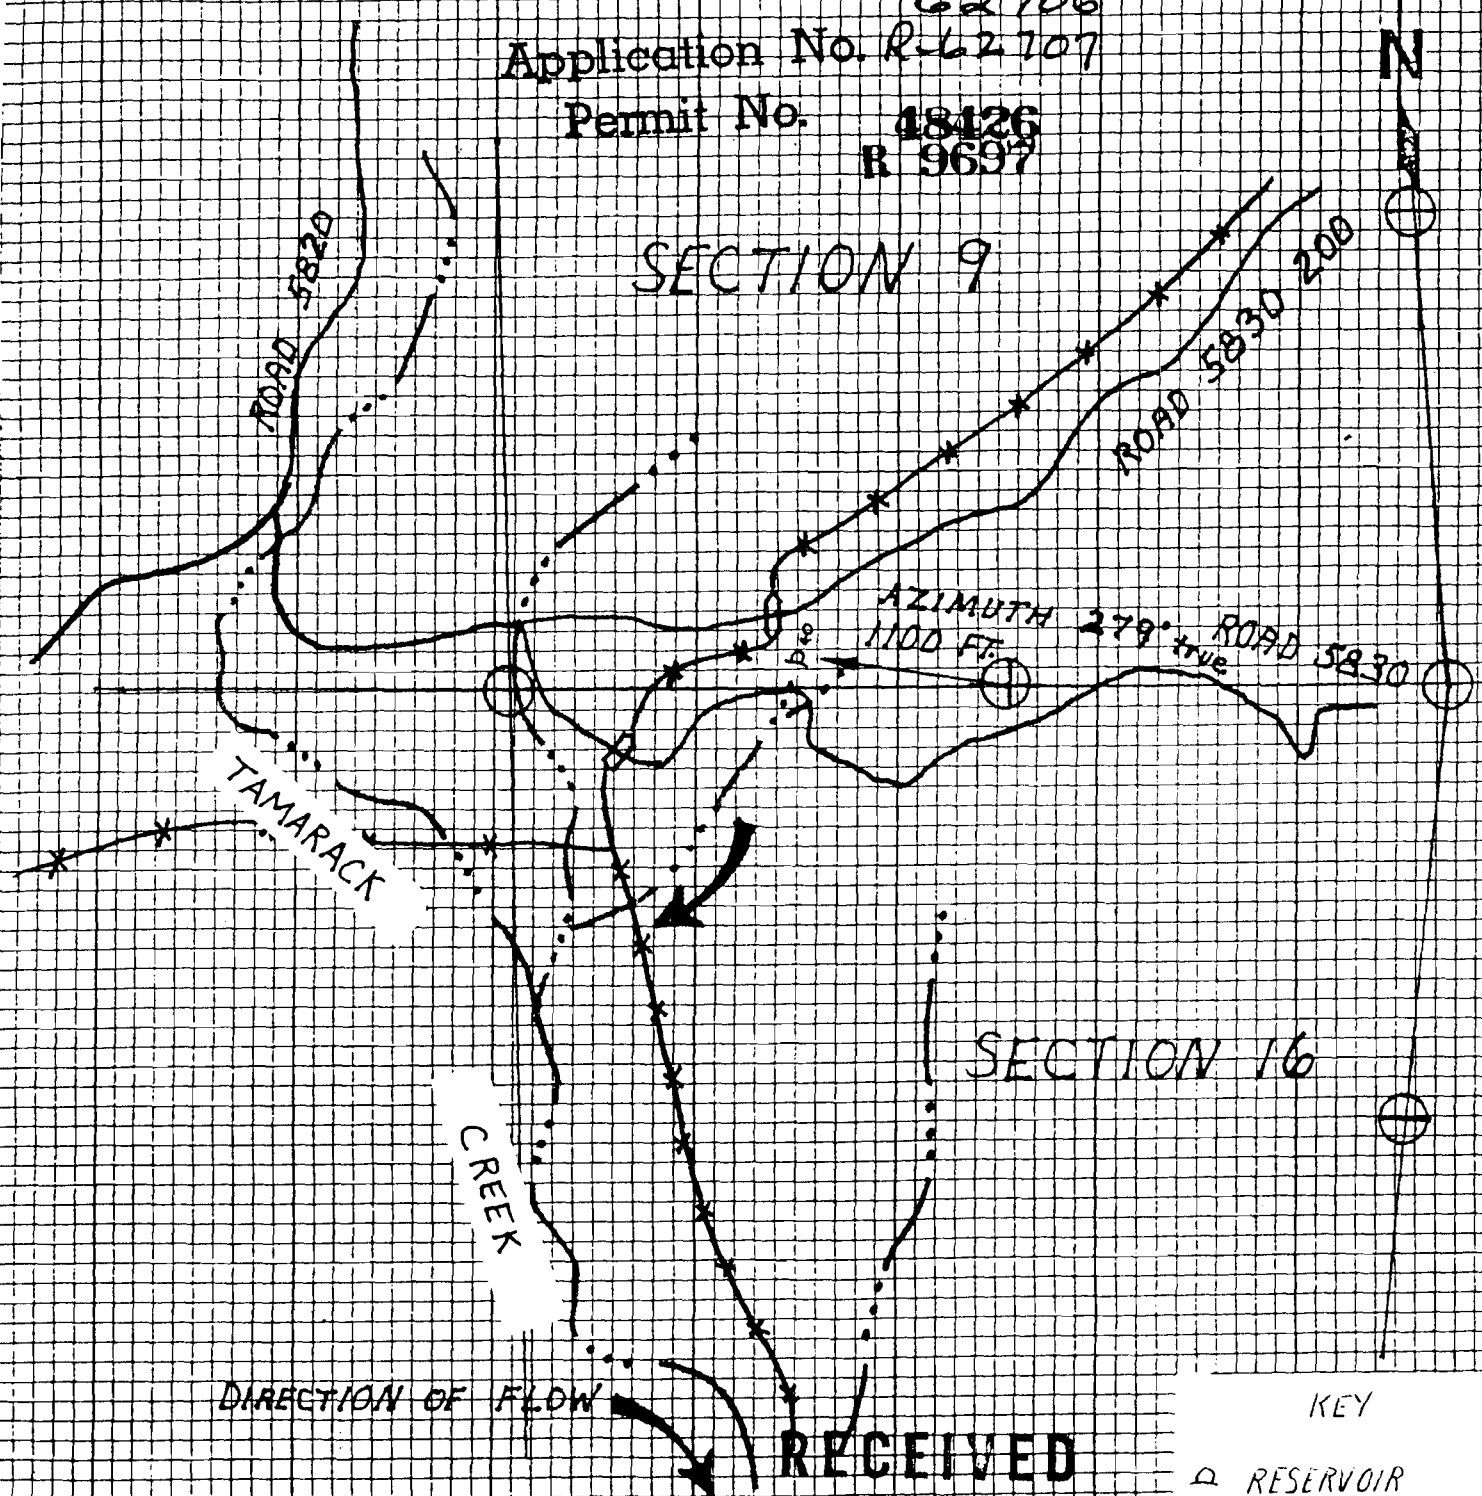

DIRECTION OF FLOW

RECEIVED

SEP 11 1981

WATER RESOURCES DEPT
SALEM, OREGON

KEY

- RESERVOIR
- SPRING
- INTERMITTENT STREAM
- ROAD
- MONUMENTED LAND LINE
- ALLOTMENT FENCE

field work by

J. F. Fickert & J. V. V. V.

date

4-15-81

plotted by

J. F. Fickert