


scale 5.28 inches = 1 mile

T 15 S R 25 E Sec 1 NW 1/4 of SE 1/4

MUD SPRING RESERVOIR

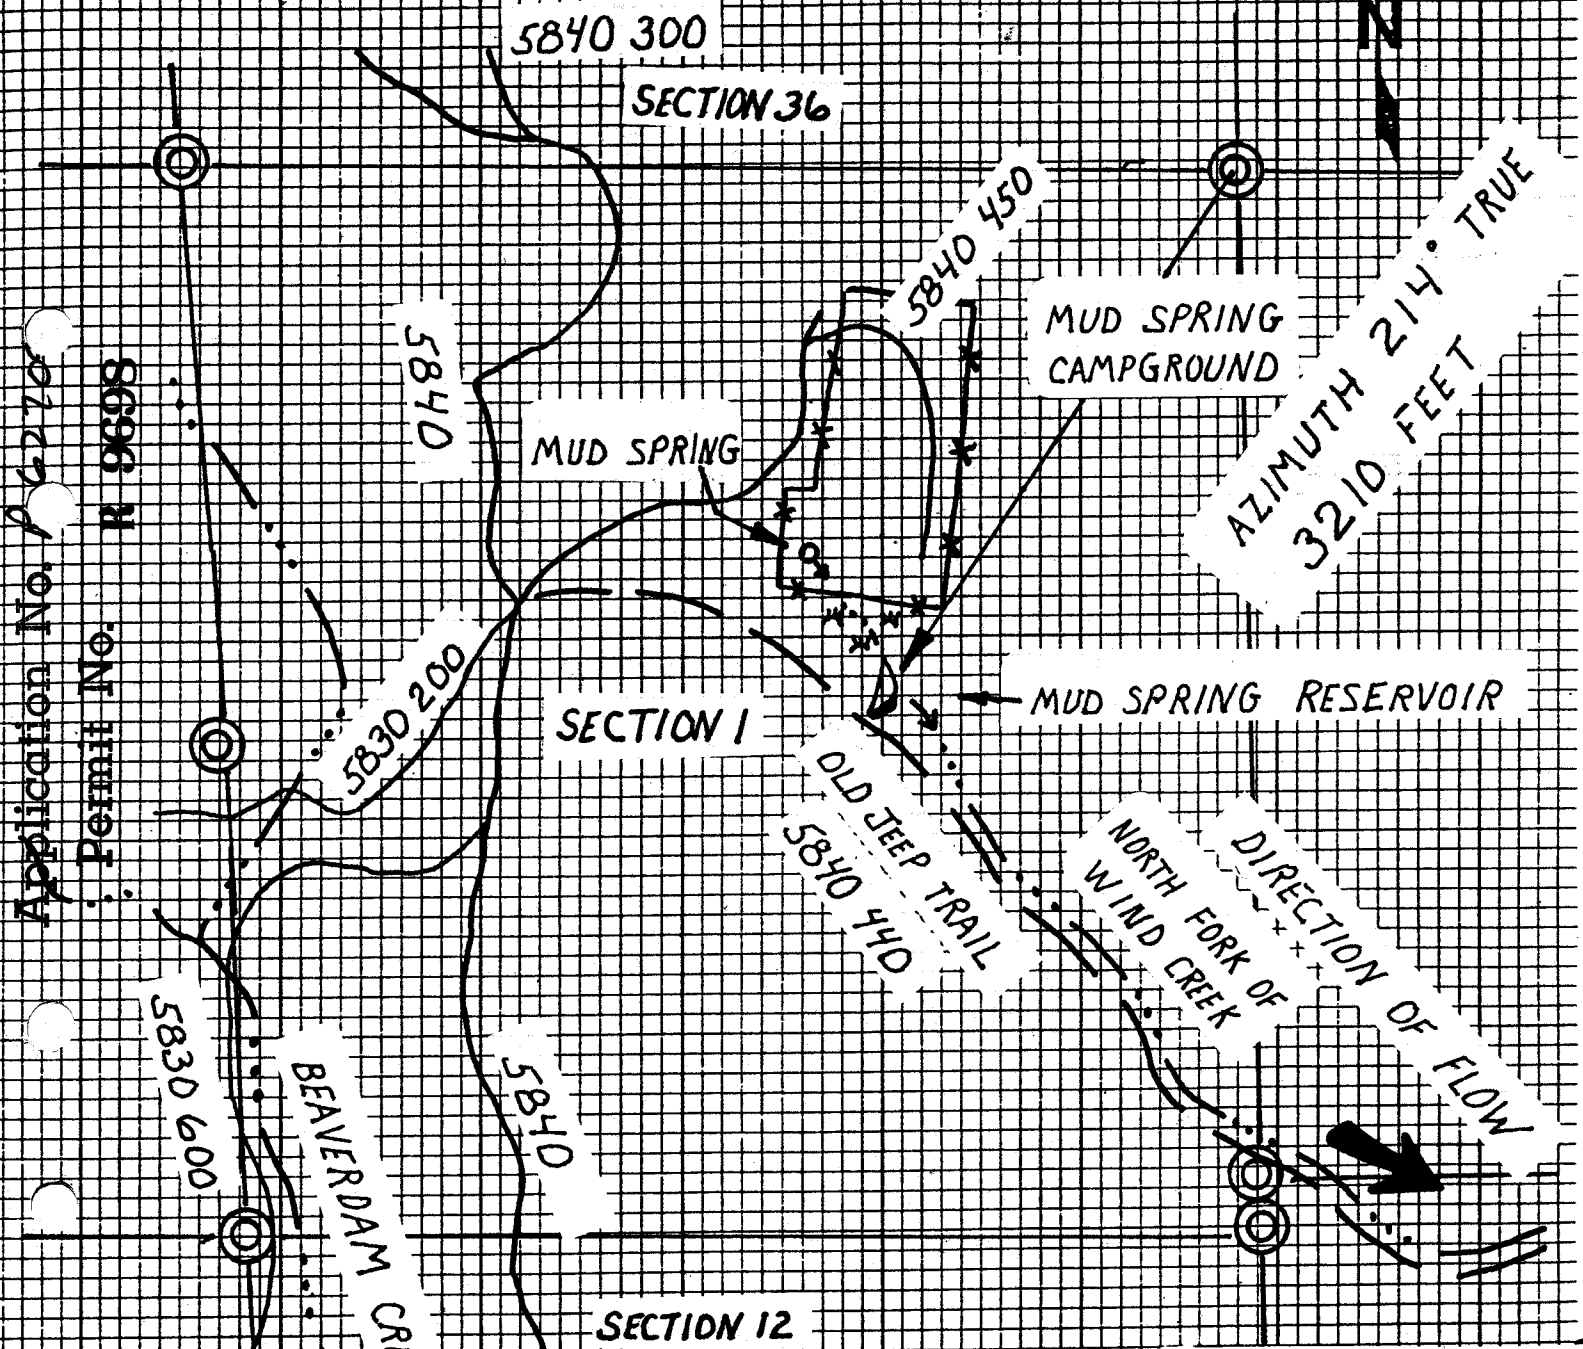

Application No. P 6270
Permit No. R 9698

RECEIVED

SEP 11 1981

WATER RESOURCES DEPT
SALEM, OREGON

field work by

date

4-17-81

platted by

J. Fitzpatrick
J. Fitzpatrick

KEY

- RESERVOIR
- SPRING & SWAMPY
- INTERMITTENT SURFACE FLOW
- FOREST SERVICE ROAD
- JEEP TRAIL
- EVIDENCE OF MONUMENTS ON SECTION LINES