

R-9857


scale 5.28 inches = 1 mile

T 16 S R 26 E Sec 17 NE 1/4 of NE 1/4

UPPER DUAL RESERVOIR

Application No. R-60683, 60684

Permit No. R 9857

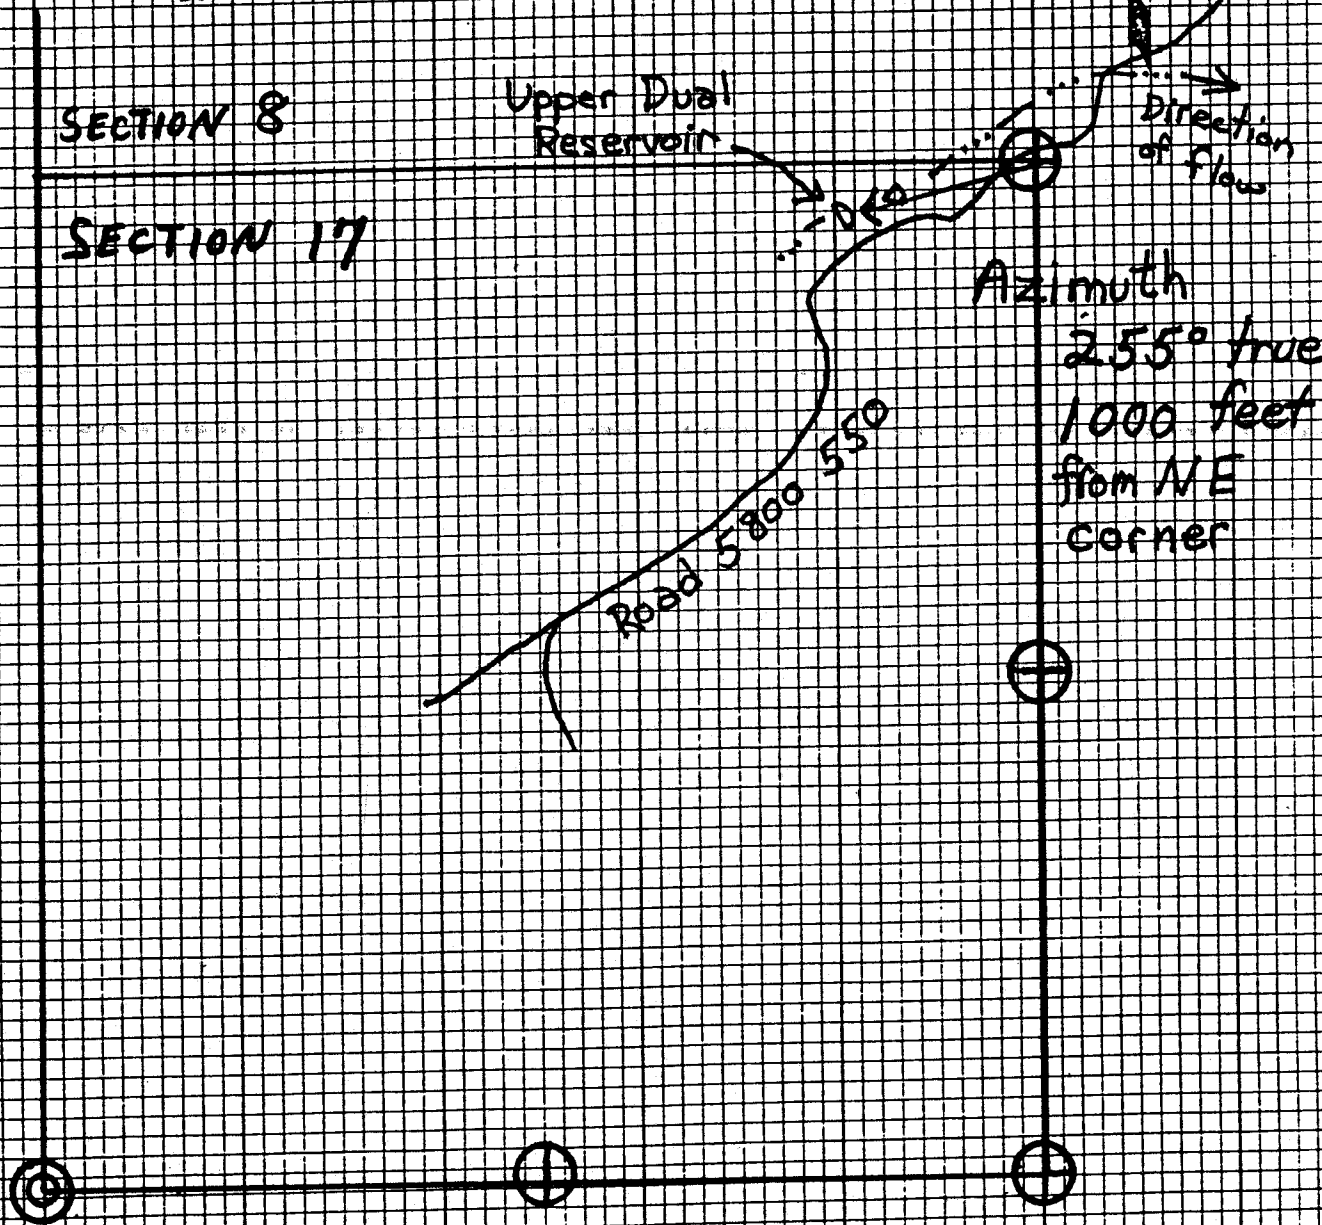

RECEIVED

SEP 15 1980
WATER RESOURCES DEPT.
SALEM, OREGON

--- intermittent stream

⊕ corner monument

⊙ corner evidence found

field work by

J. Fitzpatrick & J. Kuhn

date 7-7-80

plotted by

J. Kuhn