

scale 5.28 inches = 1 mile

T 16S R 26E Sec 17 NE 1/4 & NE 1/4

LOWER DUAL RESERVOIR


Application No. R 60685, 60686

Permit No. R 9858

SECTION 8

SECTION 17

LOWER DUAL
RESERVOIR

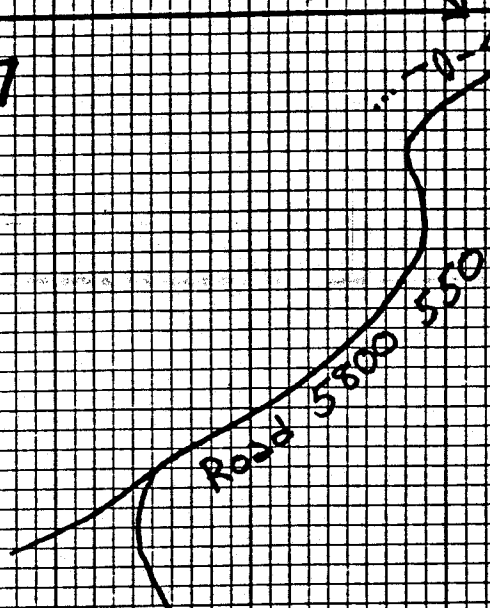

RECEIVED

SEP 15 1980

WATER RESOURCES DEPT.
SALEM, OREGON

field work by J. Fitzpatrick & J. Kuhn

date 7-7-80

plotted by J. Kuhn

intermittent
stream

⊕ corner
monumented

⊙ corner evidence
found