


scale 5.28 inches = 1 mile

T 15 S R 26 E Sec 27 SE 1/4 of NW 1/4

CAYUS RESERVOIR

Application No. R-66695, 66696

Permit No. R 9863

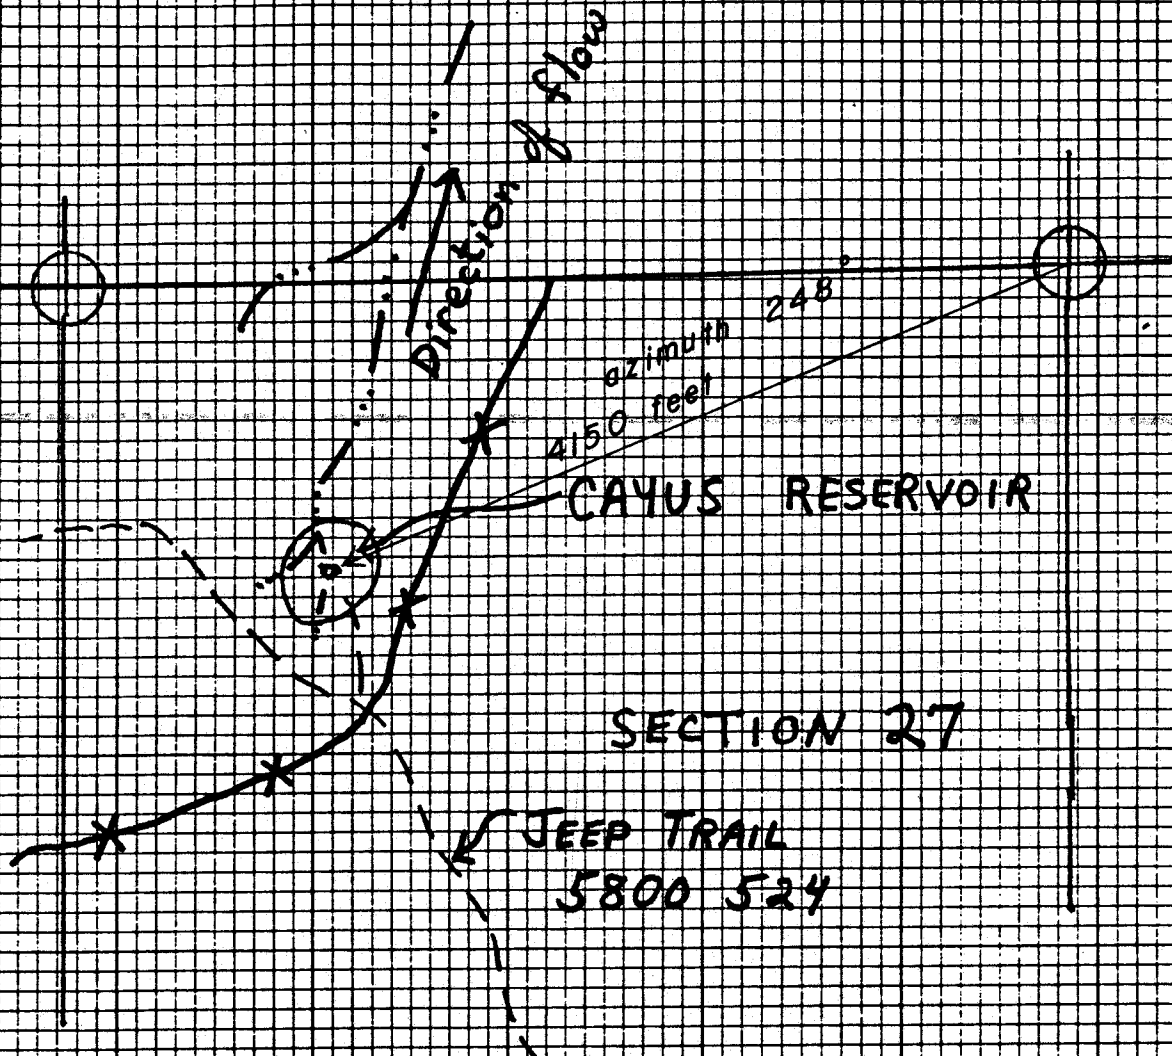

RECEIVED

SEP 15 1980

WATER RESOURCES DEPT.
SALEM, OREGON

- jeep trail
- ⊕ - monumented corner
- intermittent stream
- ** - fence line

field work by

Jean Fitzpatrick

date

5/22/80

plotted by

Jean Fitzpatrick