

R-9864


OCHOCO NATIONAL FOREST

PAULINA RANGER DISTRICT

scale 5.28 inches = 1 mile

T 16 S R 26 E Sec 4 SW 1/4 of NE 1/4

Draw Pond

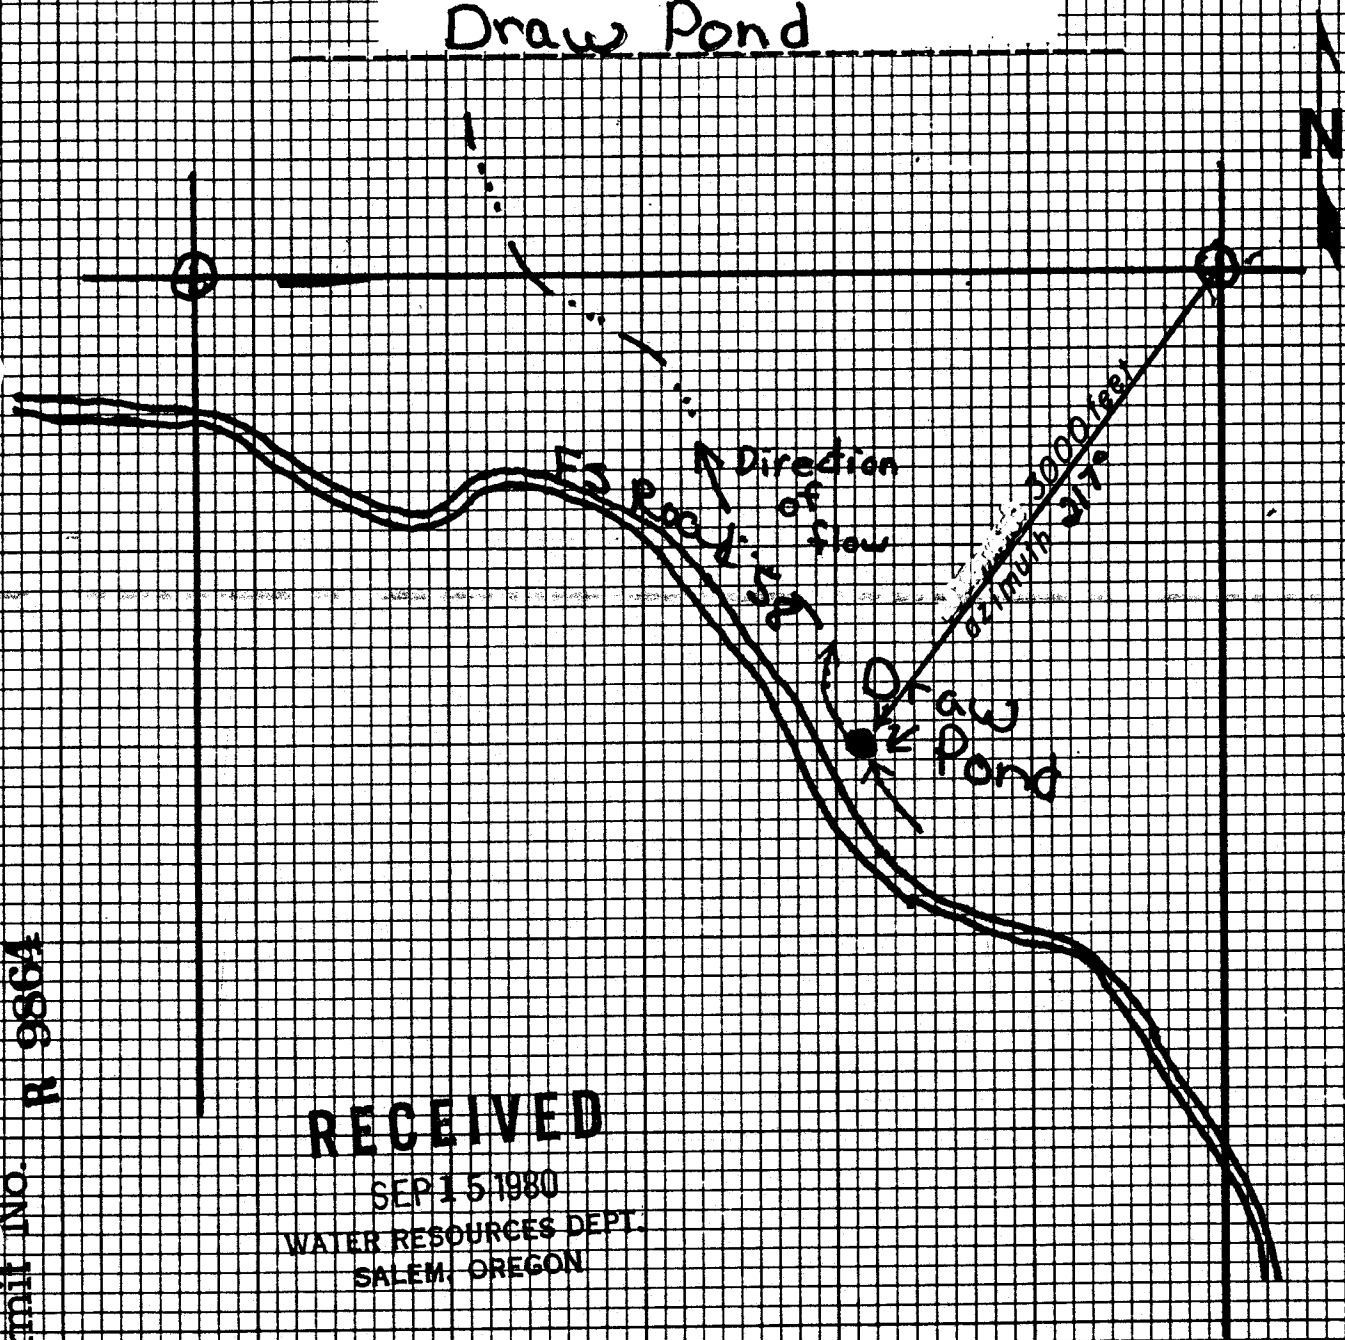


RECEIVED

SEP 15 1980

WATER RESOURCES DEPT.
SALEM, OREGON



corners
monumented

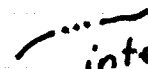

intermittent stream



Forest Service road

field work by

J. Fitzpatrick & J. Xuhn

date

6-25-80

plotted by

J. Xuhn

Application No. R-60697, 60698
Permit No. R 9864