


R-9870

scale 5.28 inches = 1 mile

T 15 S R 26 E Sec 28 NE 1/4 of SW 1/4

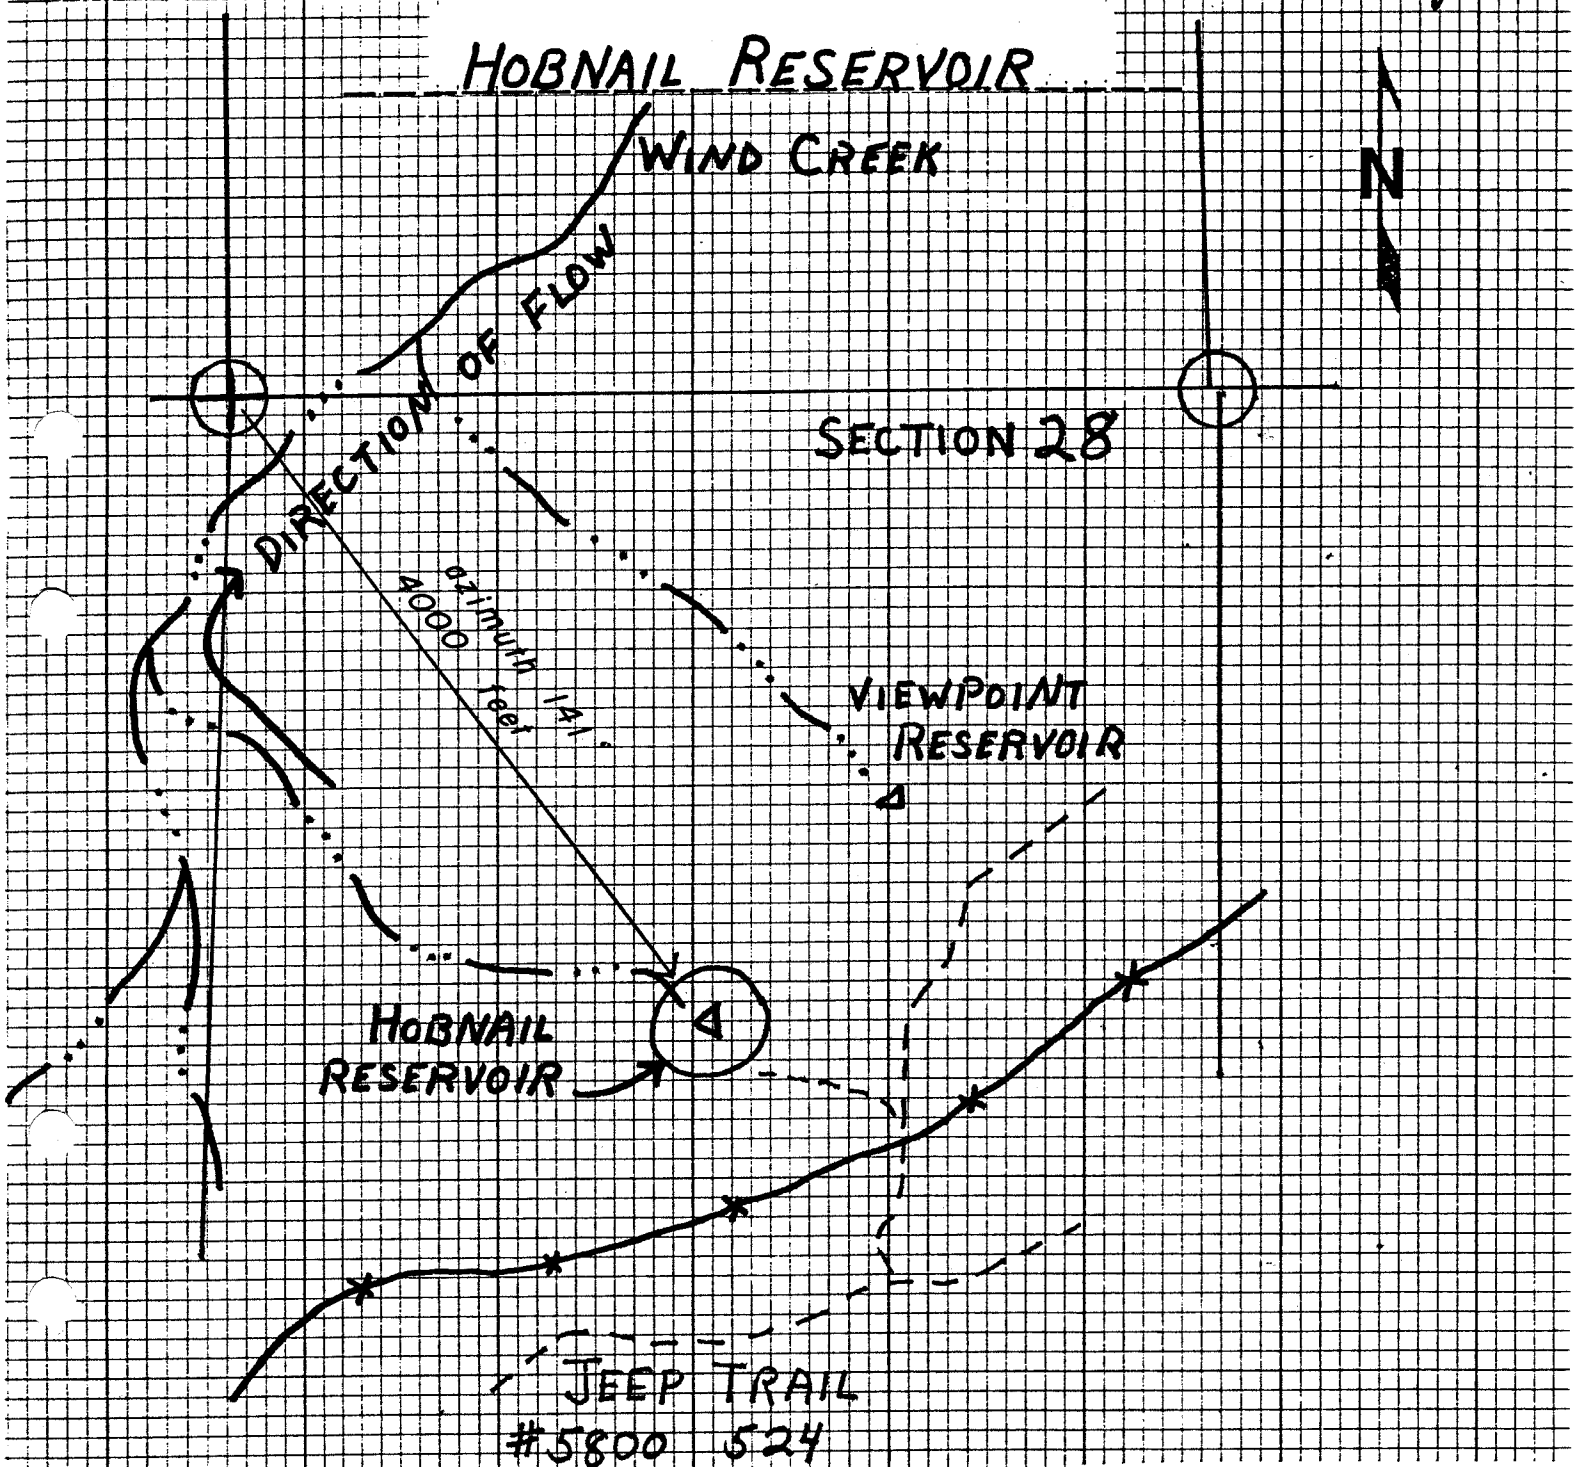

RECEIVED

001071980

WATER RESOURCES DEPT
SALEM, OREGON

- ~...~ intermittent stream
- perennial stream
- ⊕ corner monumented
- * * * fenceline
- jeep trail

field work by

Jean Fitzpatrick

date

5.22.80

platted by

Jean Fitzpatrick

Application No. R 60864
Permit No. R 9870