

UNITED STATES
DEPARTMENT OF THE INTERIOR
BUREAU OF LAND MANAGEMENT


SECTION

21
22
23
24

Oregon State Water Filings

TOWNSHIP 20S, RANGE 21E, W. M.

North

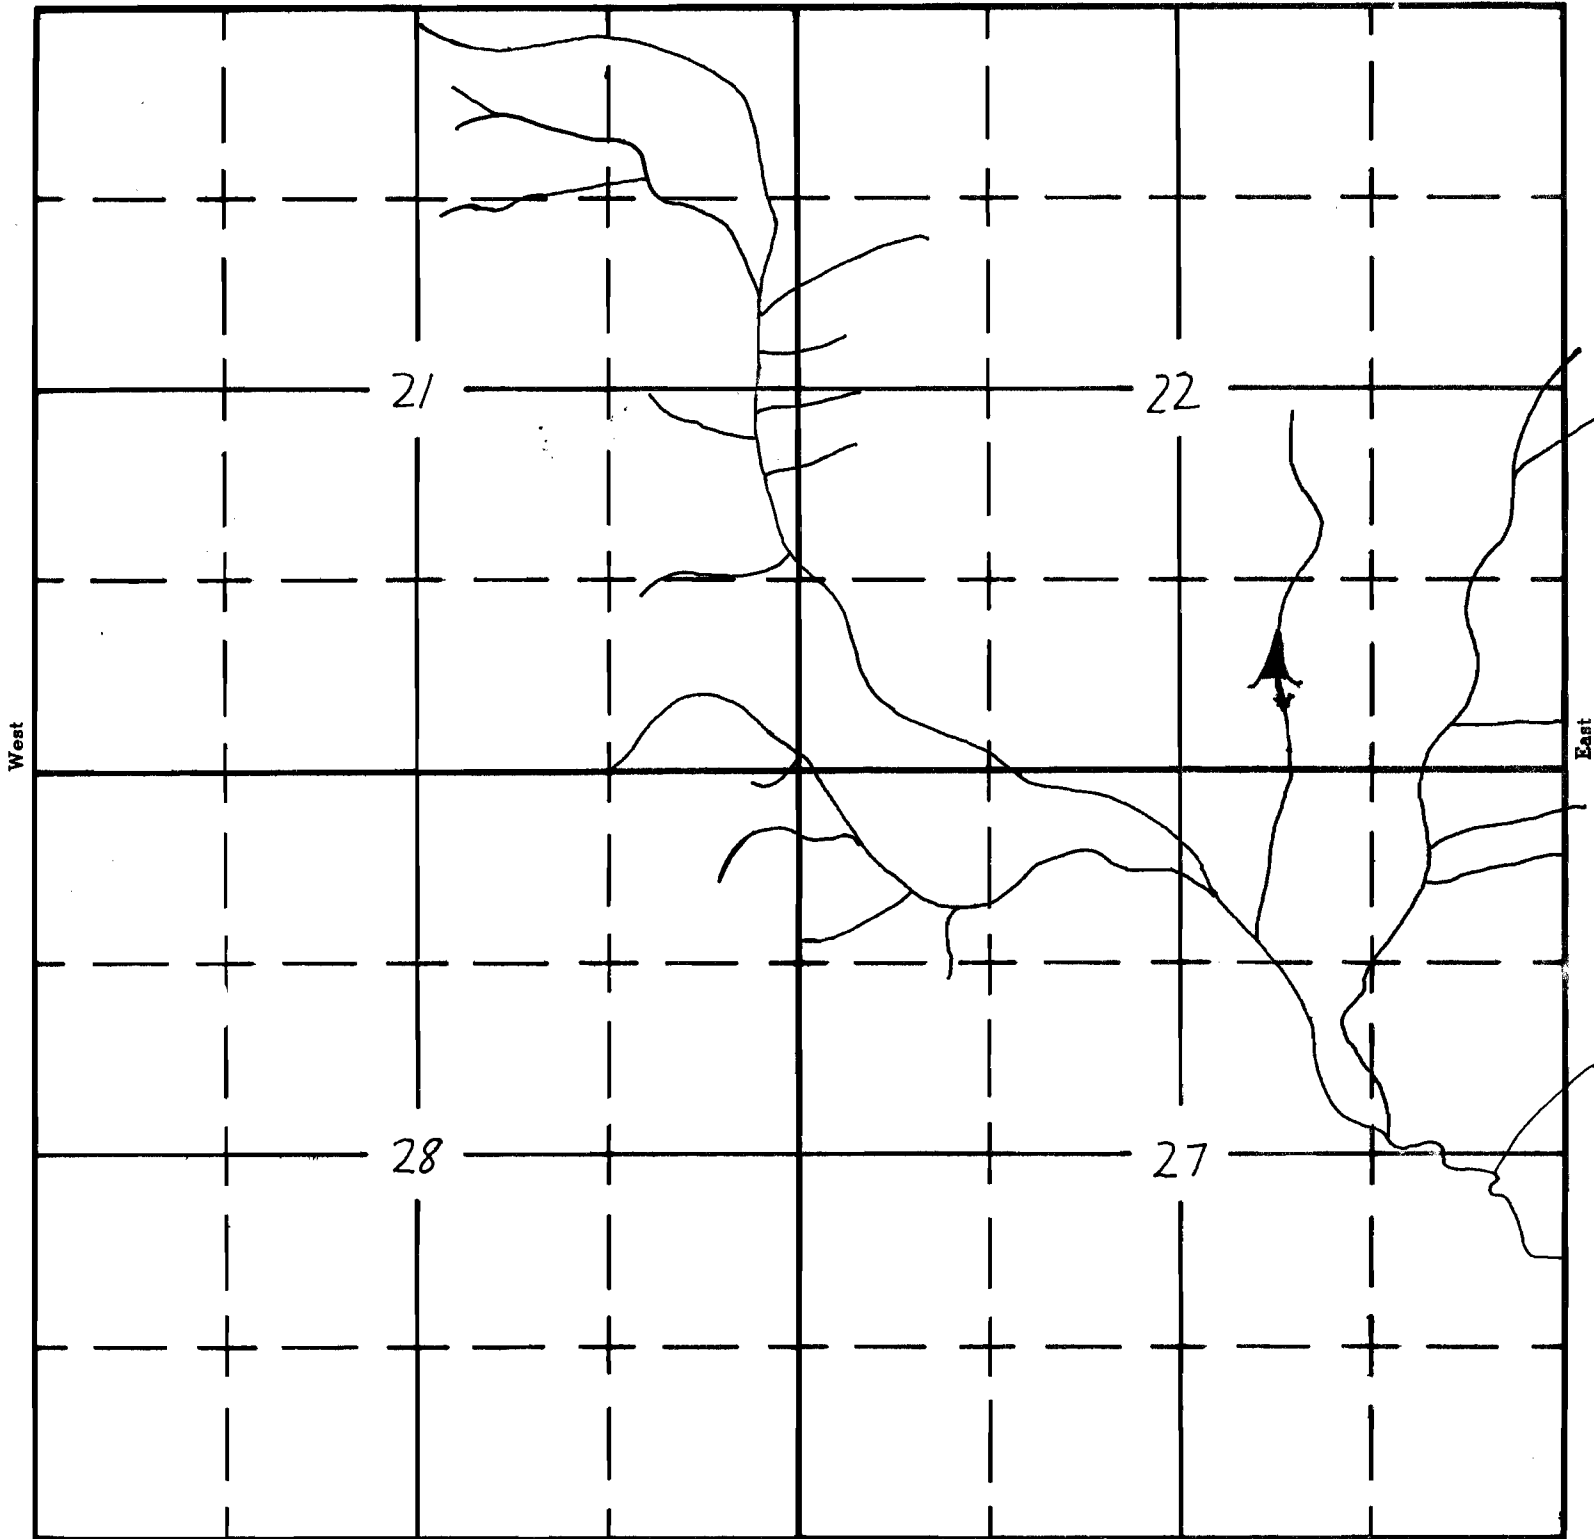

North Draw

Application No.
Permit No.

South
R-34045
R-2480

APPLICATION No.
PERMIT No.