

UNITED STATES
DEPARTMENT OF THE INTERIOR
BUREAU OF LAND MANAGEMENT

SECTION

21

22


23

24

Oregon State Water Filings

TOWNSHIP 20S, RANGE 2/E, W. M.

North

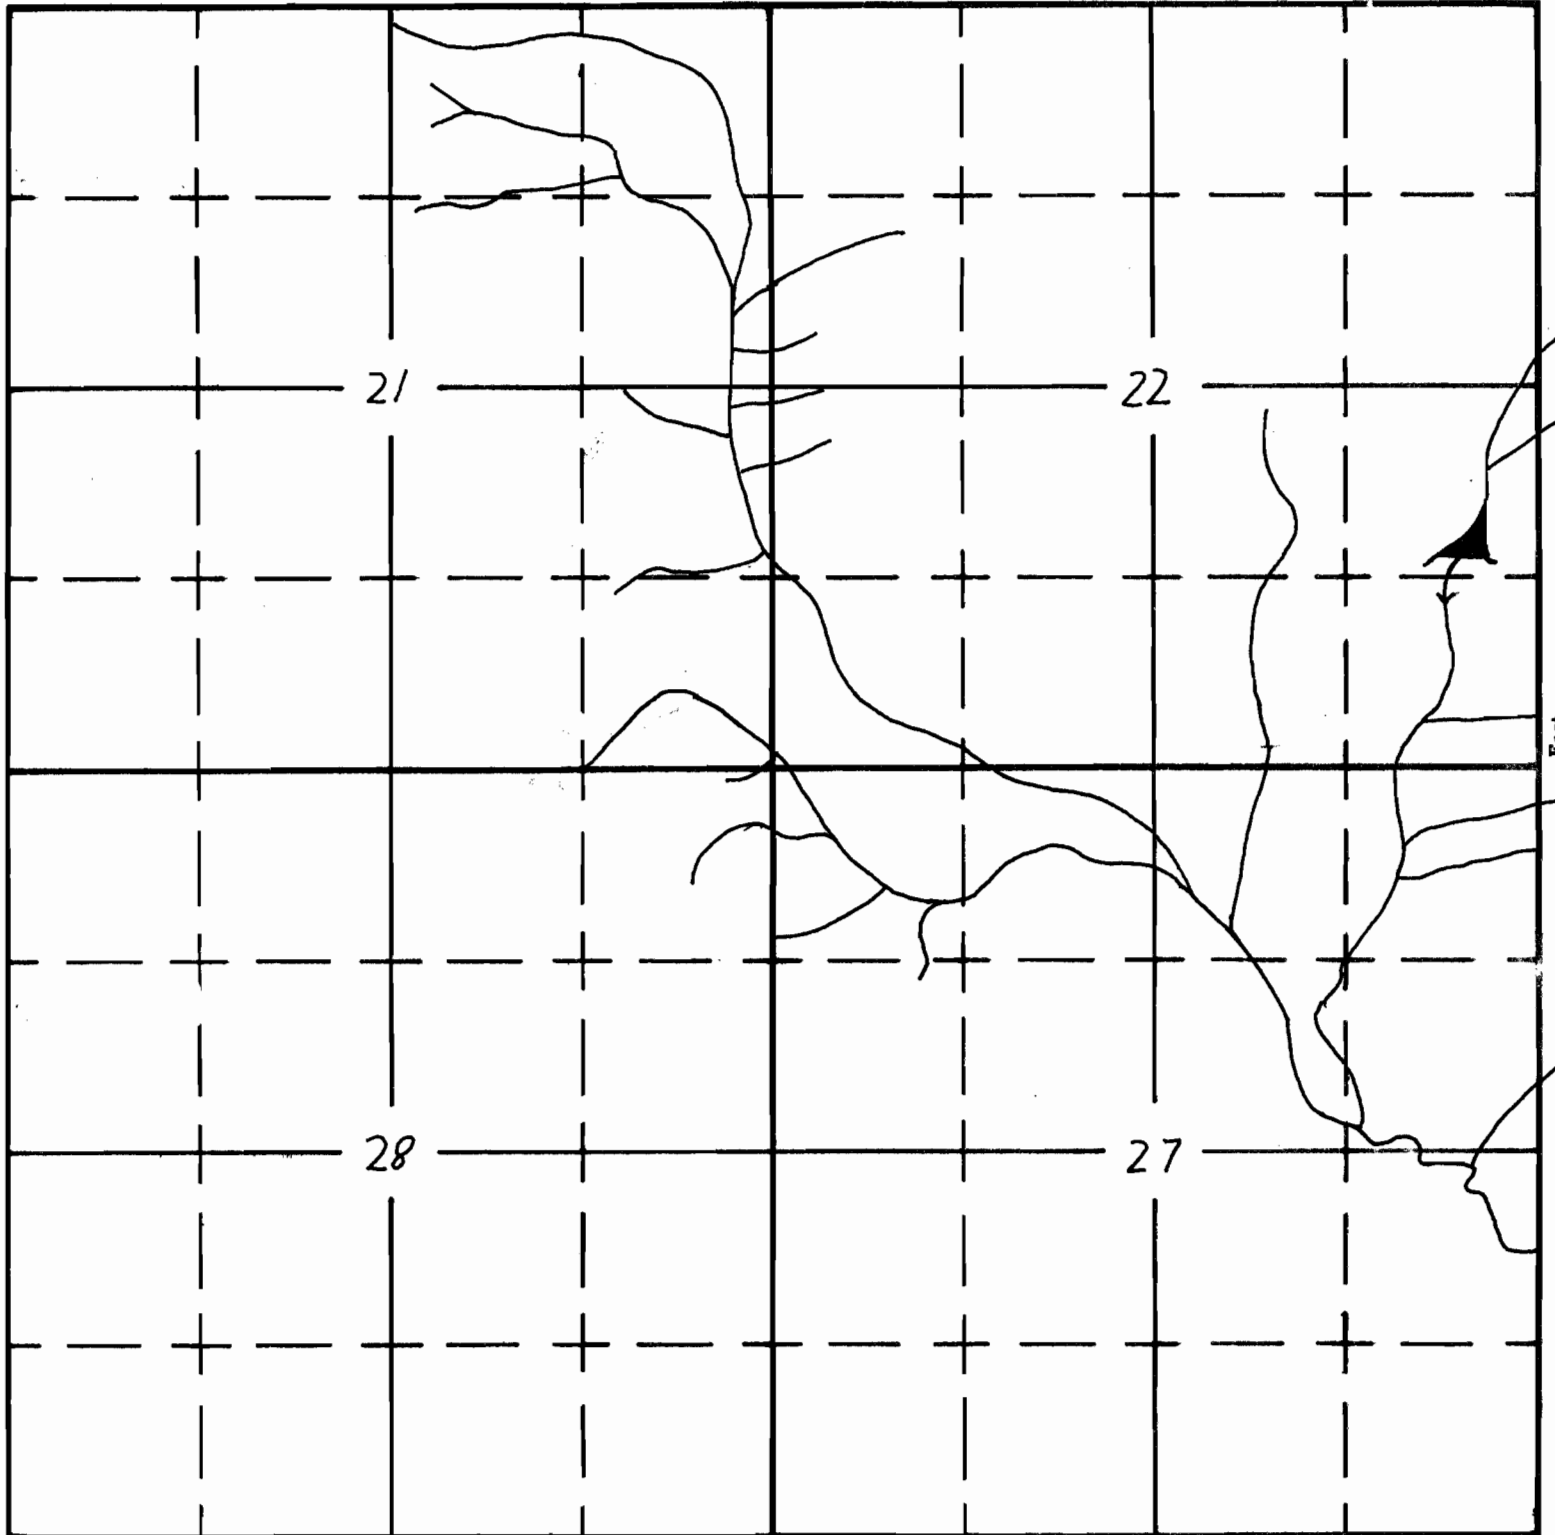

Little Butte #1

South

Application No. R-34046

Permit No. R-2481

APPLICATION No.

PERMIT No.