

UNITED STATES
DEPARTMENT OF THE INTERIOR
BUREAU OF LAND MANAGEMENT


SECTION

8

Oregon State Water Filings

TOWNSHIP 16 S., RANGE 22 E., W. M.

North

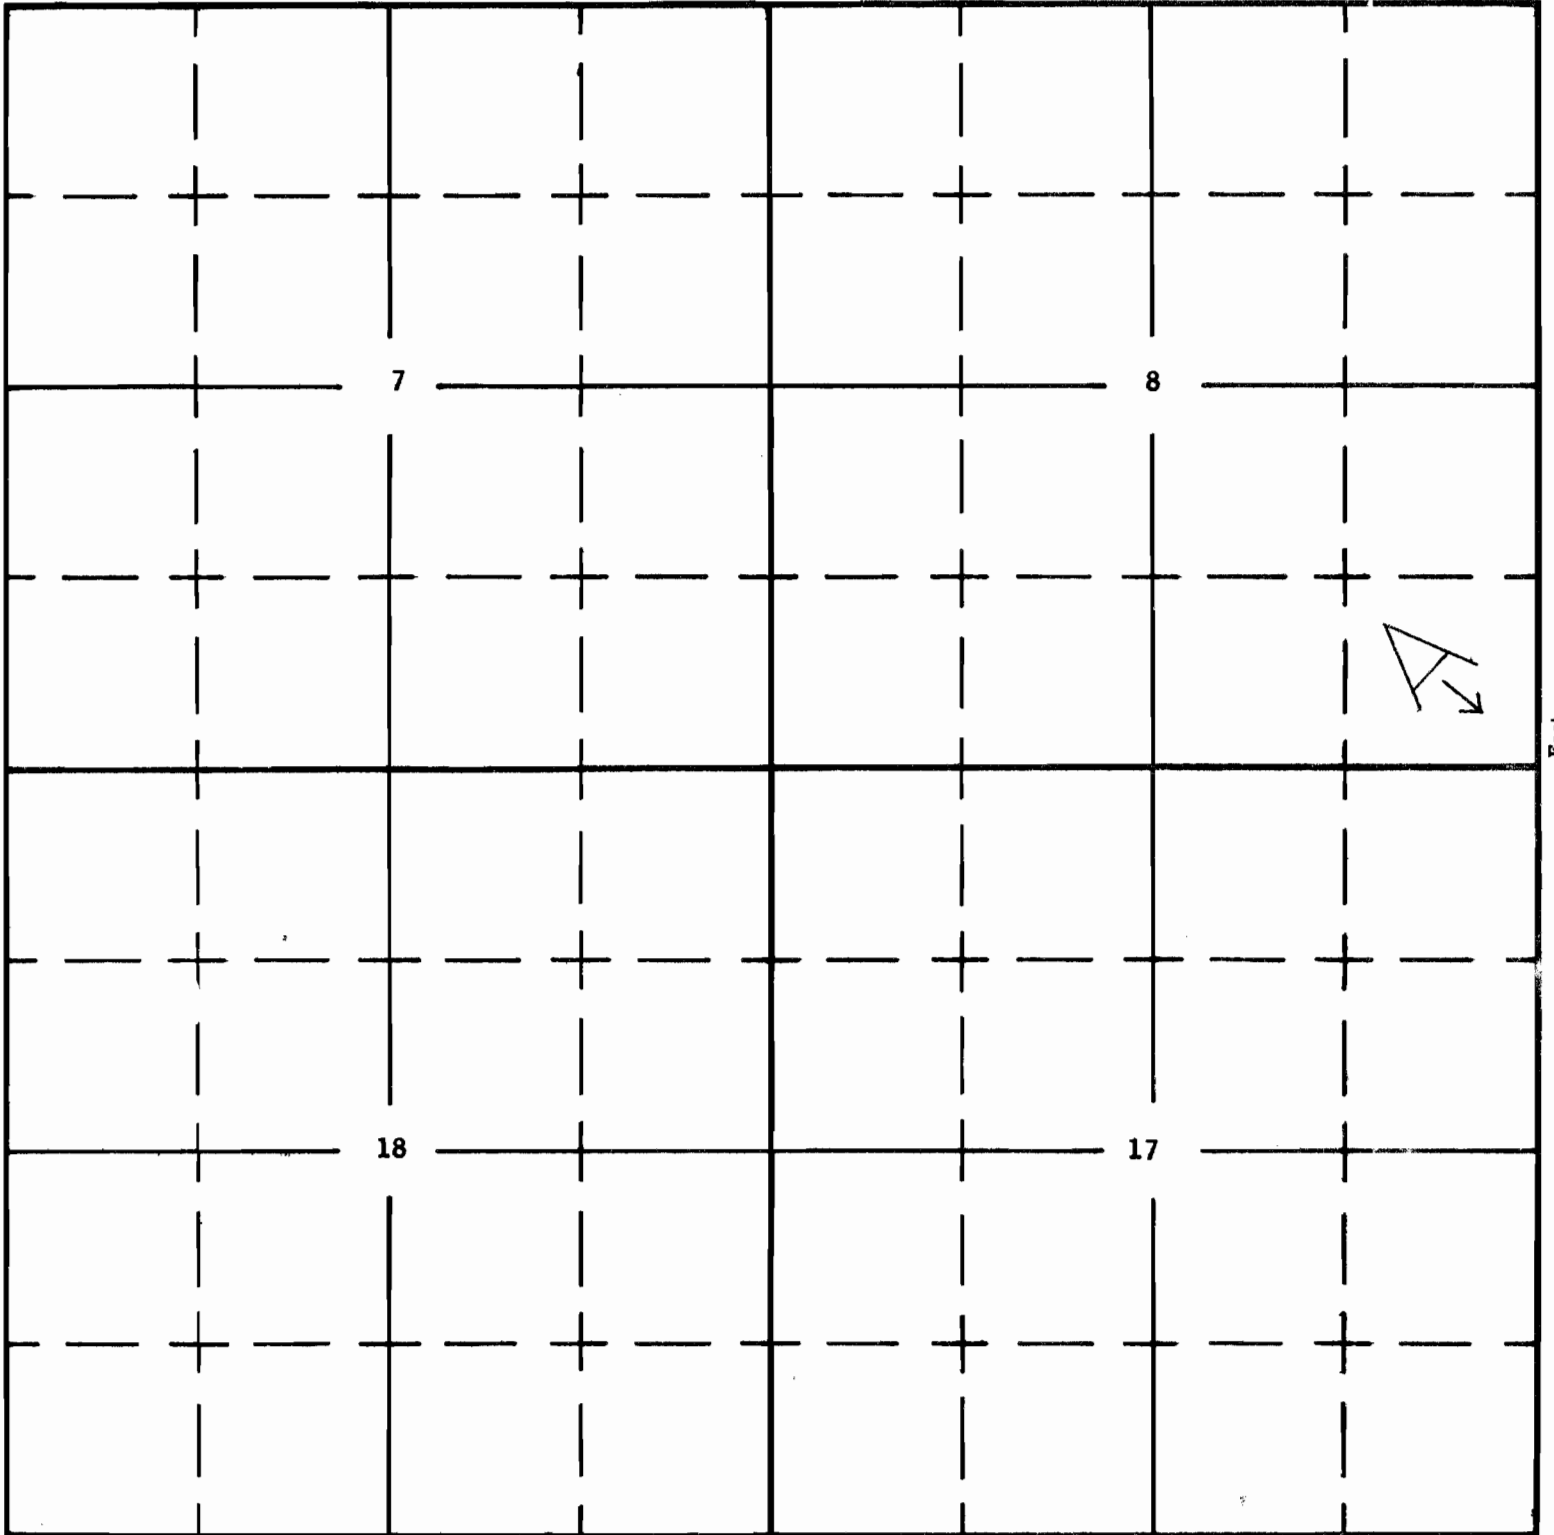

South

APPLICATION No. R-34433
PERMIT No. R-2563