


UNITED STATES
DEPARTMENT OF THE INTERIOR
BUREAU OF LAND MANAGEMENT

SECTION 18

Oregon State Water Filings

TOWNSHIP 16 S., RANGE 22 E., W. M.

North

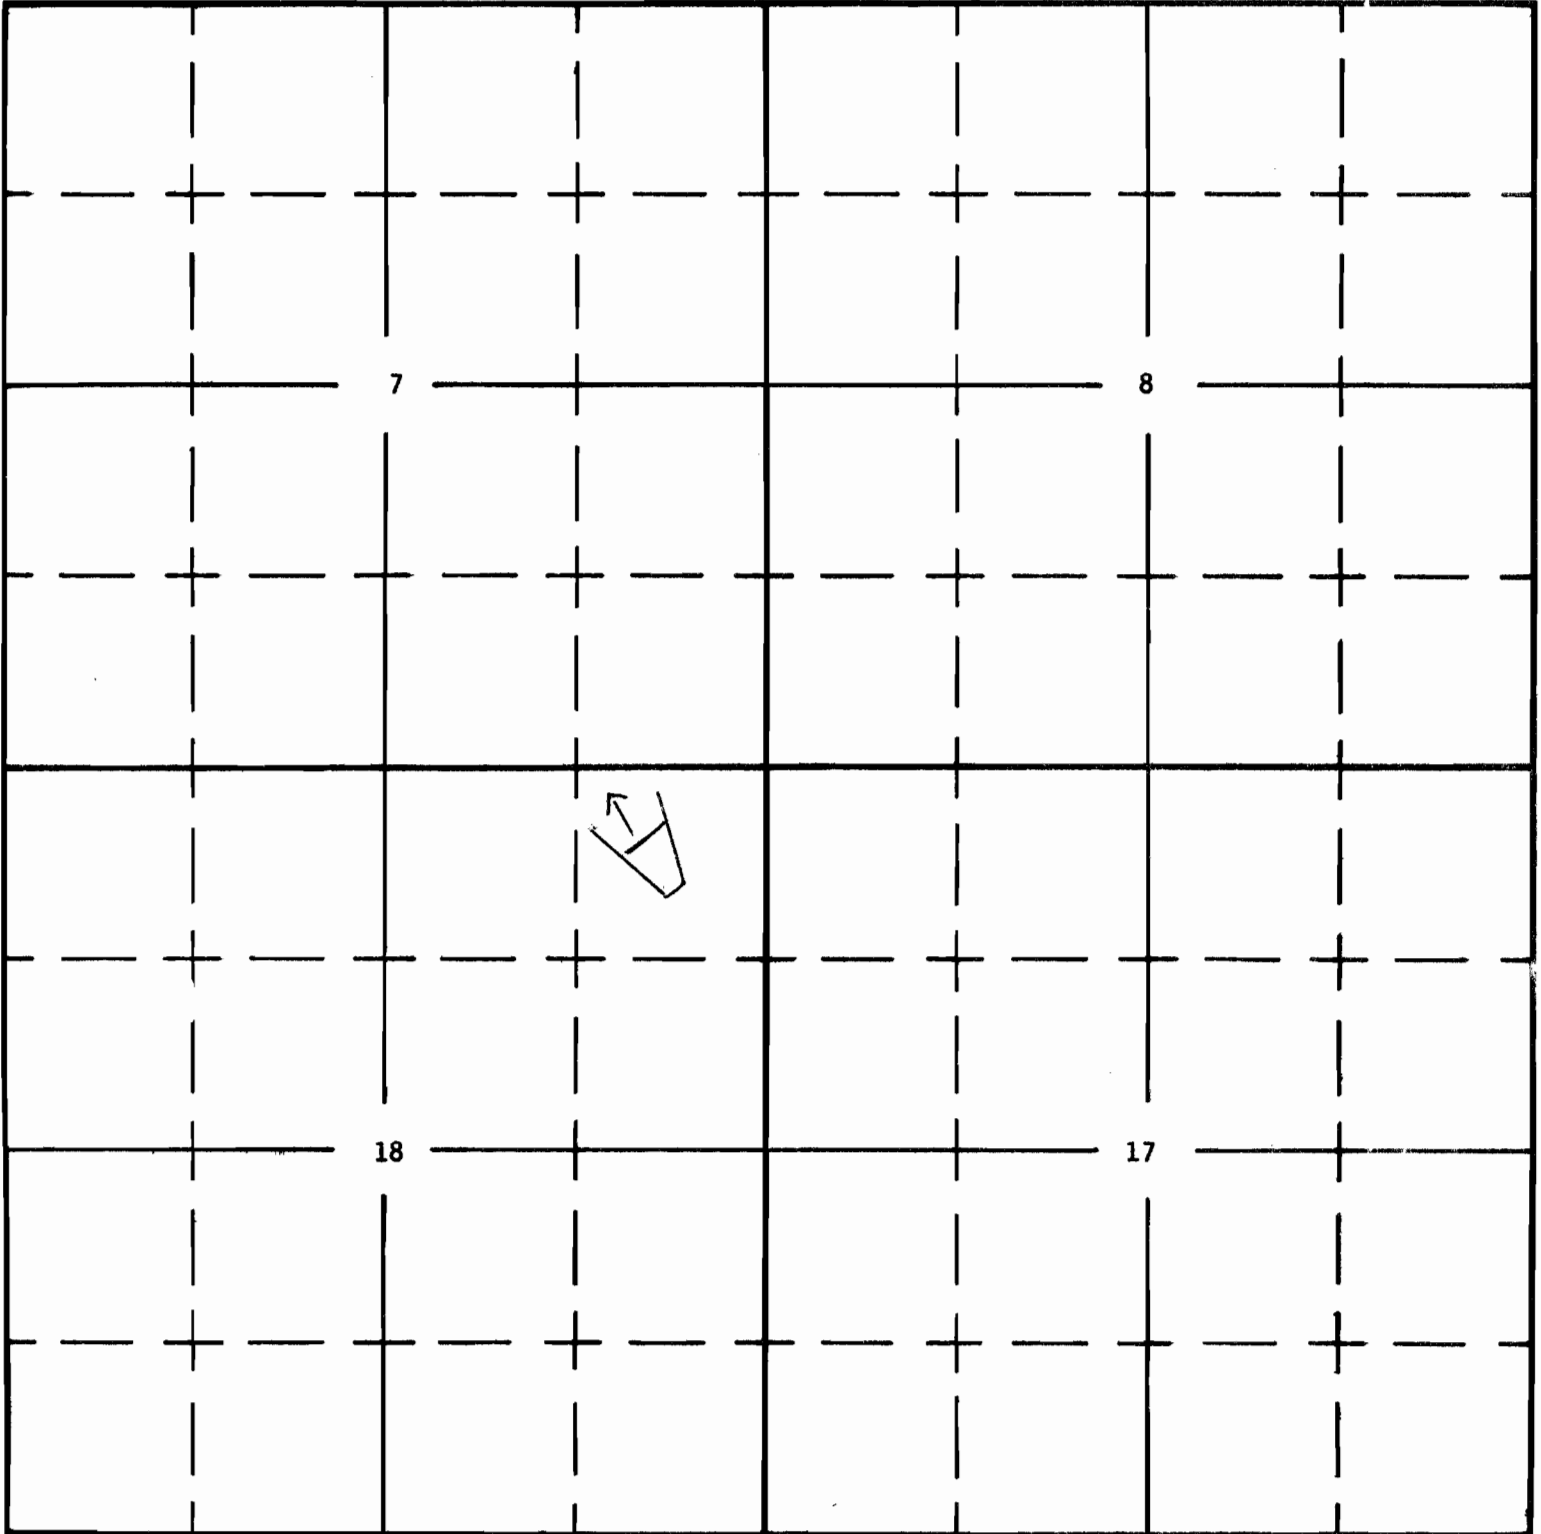

West

East

South

APPLICATION No. R-34434
PERMIT No. R-2564