

UNITED STATES
DEPARTMENT OF THE INTERIOR
BUREAU OF LAND MANAGEMENT


SECTION _____

Oregon State Water Filings

TOWNSHIP 16 S., RANGE 22 E., W. M.

STATE OF OREGON
BUREAU OF LAND MANAGEMENT
LAND OFFICE
SACRAMENTO, CALIF.

North

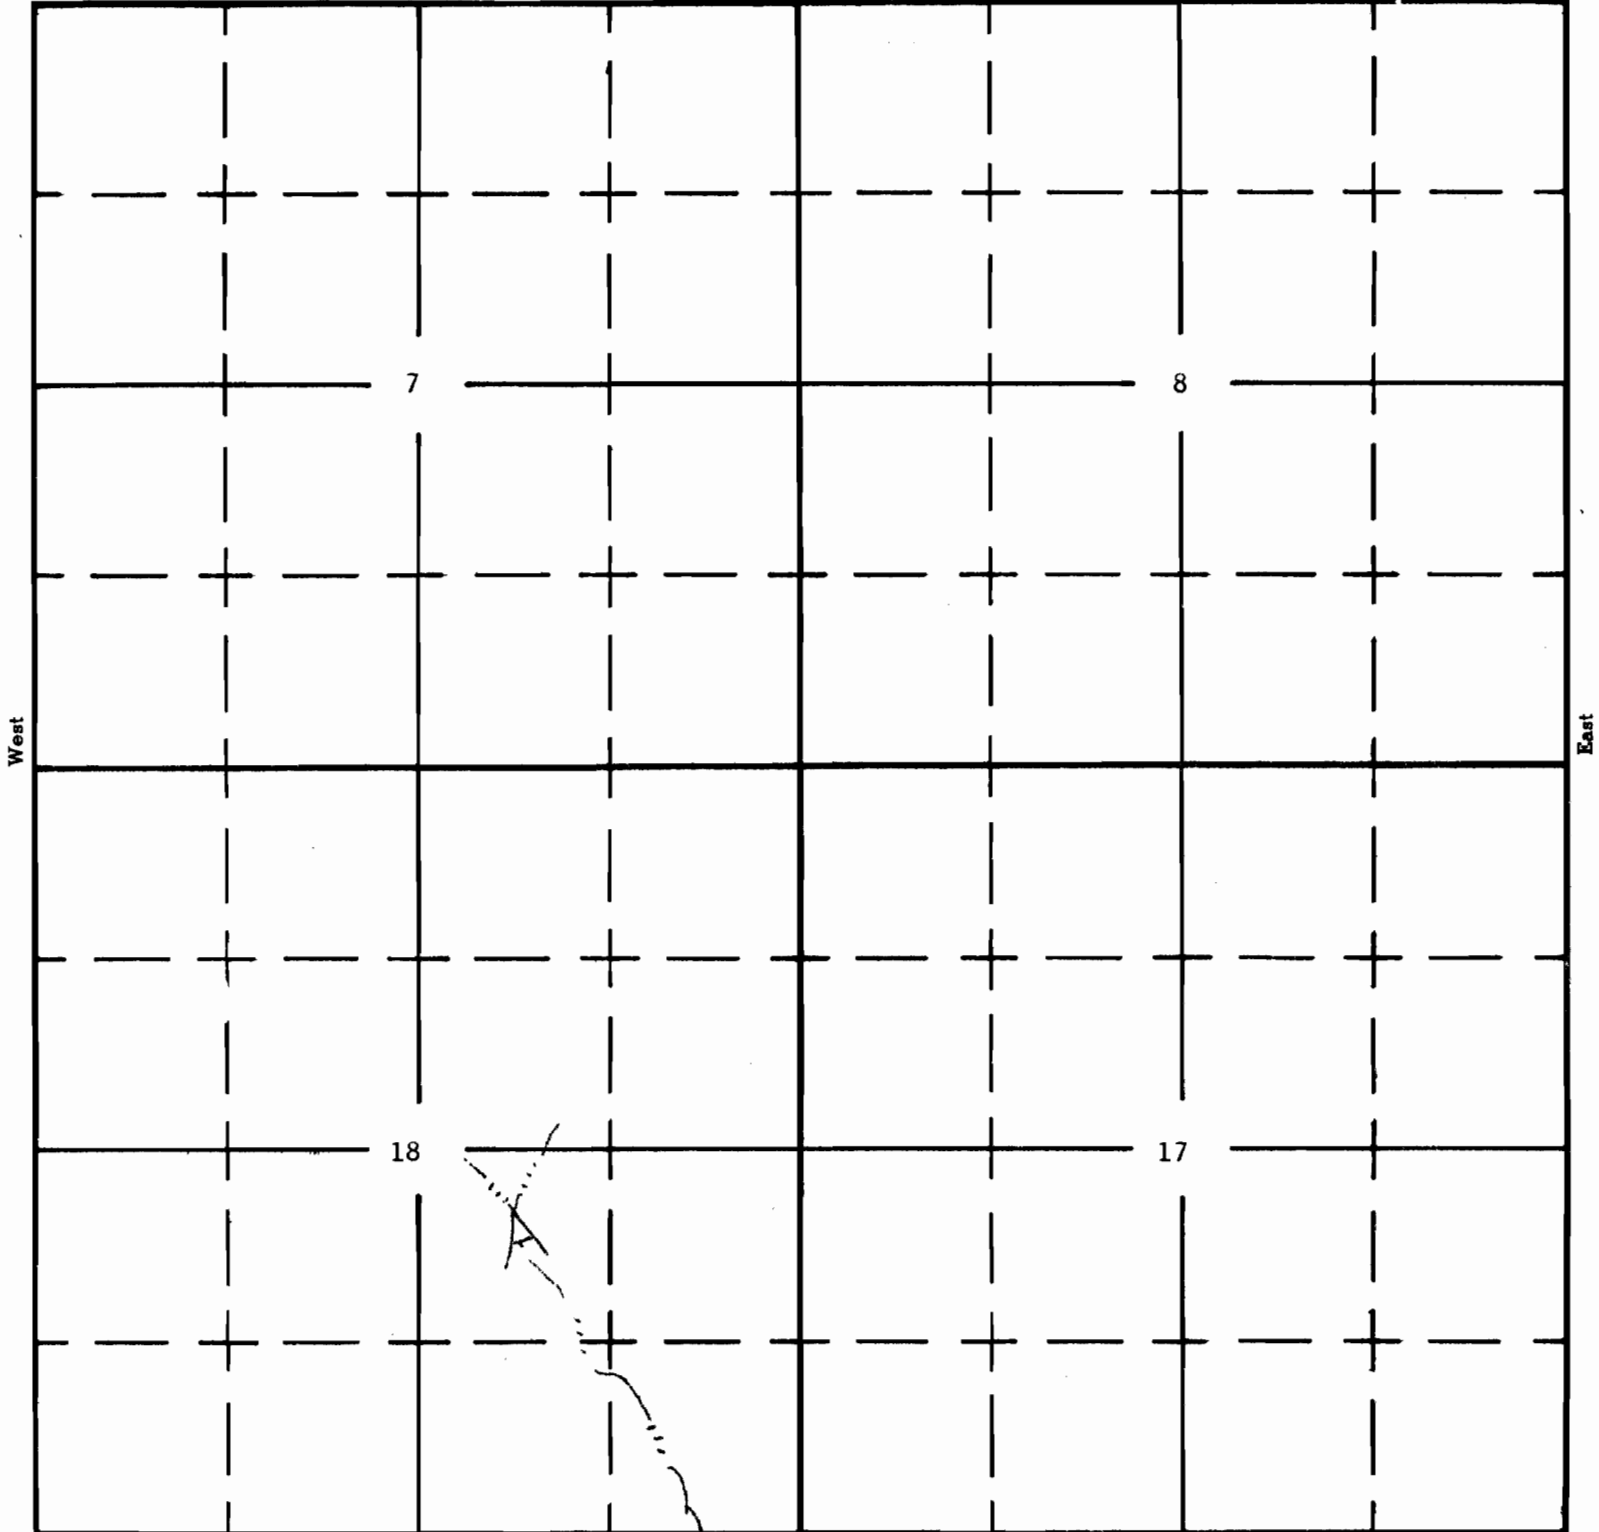

Hole in the Ground

APPLICATION No. *R-34436*
PERMIT No. *R-2566*