


P-5430-2
Nov. 1964
(formerly A1-29)

UNITED STATES
DEPARTMENT OF THE INTERIOR
BUREAU OF LAND MANAGEMENT

0012

SECTION DIAGRAM

MAP CONTRACT No. 14-11-0001()-
T. 15 S. R. 23 E. SEC. 28, WillMER. Prineville DISTRICT
MAPPER DATE

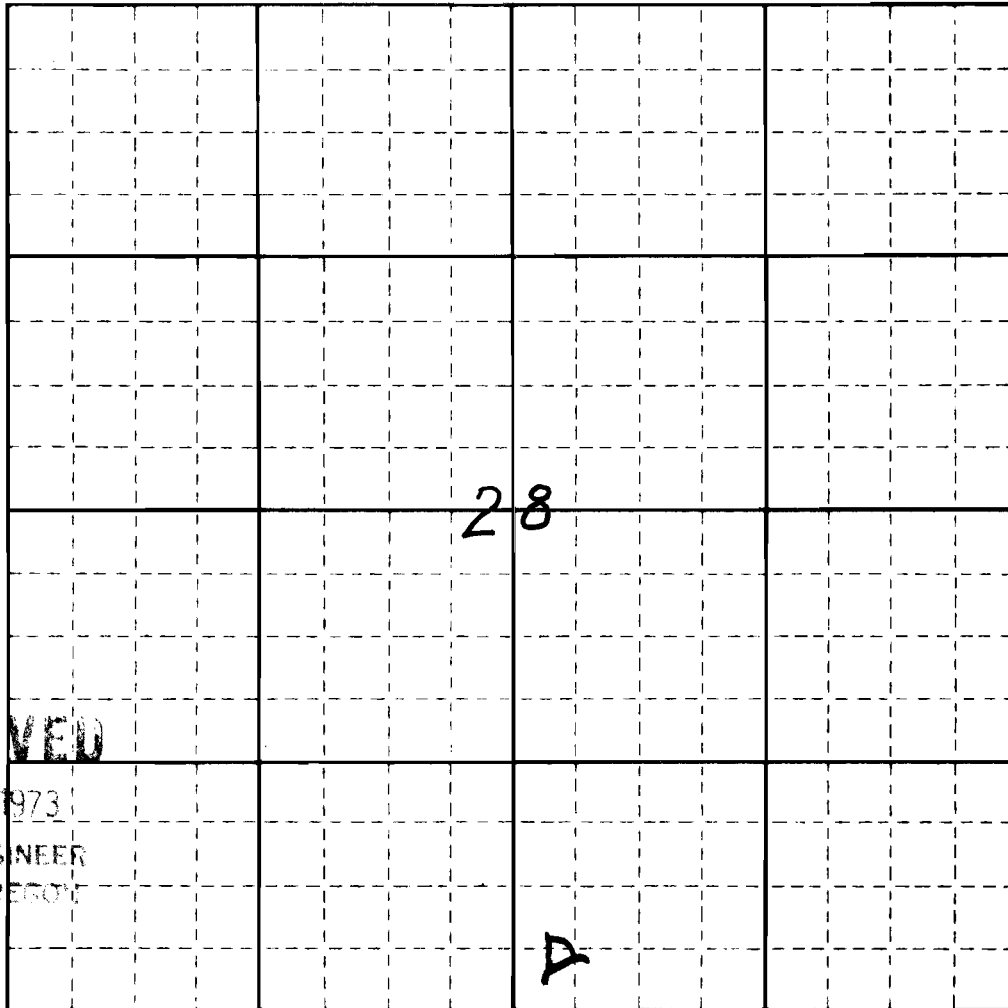

SCALE: 1" = 1,000 FT.

LEGEND

	MAINLINE ROAD
	PROPOSED SPUR ROADS
	YARDING ROADS (CAT OR HIGH LEAD)
	SPAR TREES (YARDING OR LOADING)
	CORNERS FOUND
	BOUNDARY - CONTRACT AREA
	BOUNDARY - CUTTING AREA

Application No. R-51388
Permit No. R 7521