


P-5430-2
Nov. 1964

UNITED STATES
DEPARTMENT OF THE INTERIOR
BUREAU OF LAND MANAGEMENT

SECTION DIAGRAM

MAP CONTRACT No. 14-11-0001()-
T. 18 S. R. 23 E. SEC. 14, Will. MER. Prineville DISTRICT
MAPPER _____ DATE _____

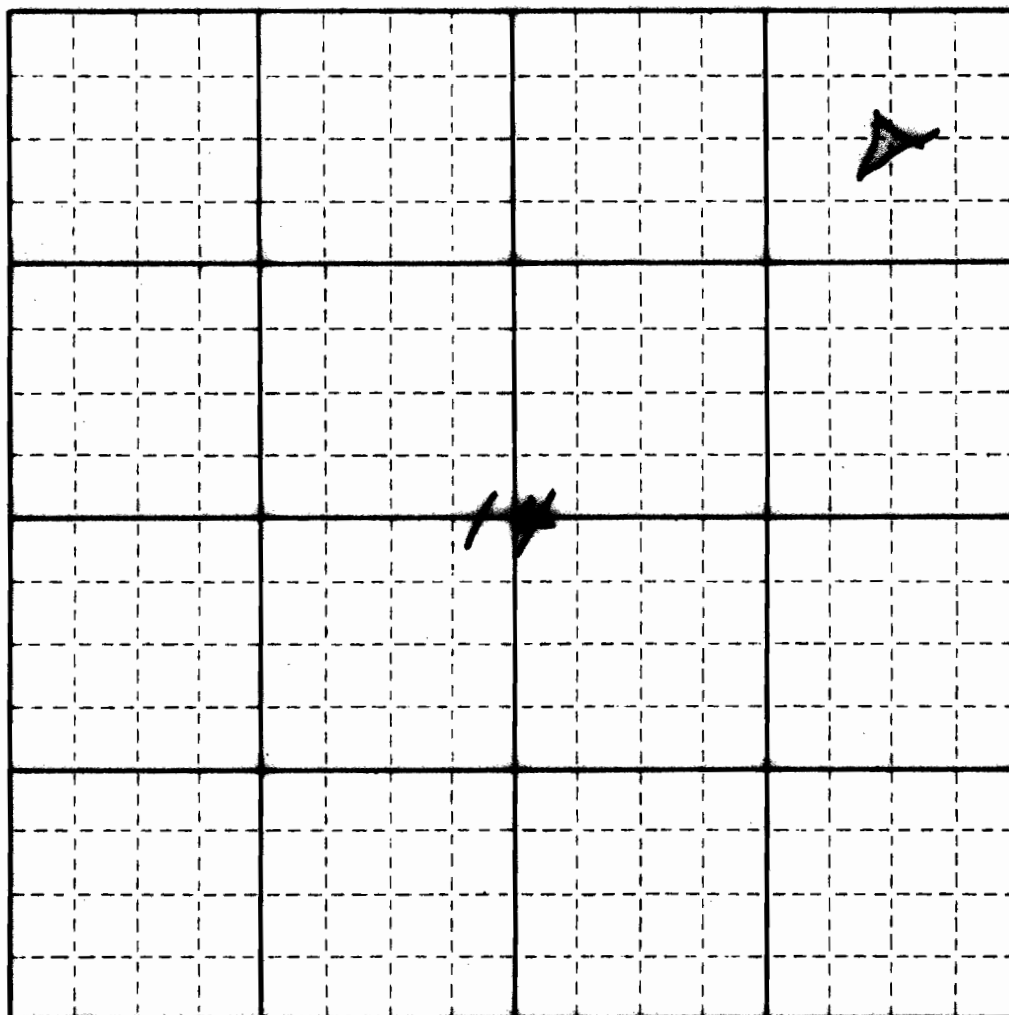

SCALE: 1" = 1,000 FT.

LEGEND

☐	_____	=====	MAINLINE ROAD
☐	_____	----	PROPOSED SPUR ROADS
☐	_____	oooooo	YARDING ROADS (CAT OR HIGH LEAD)
☐	_____	⊙	SPUR TREES (YARDING OR LOADING)
☐	_____	●	CORNERS FOUND
☐	_____	----	BOUNDARY - CONTRACT AREA
☐	_____	=====	BOUNDARY - CUTTING AREA

RECEIVED

NOV 14 1973

STATE ENGINEER
SALEM, OREGON

Application No. R-51412
Permit No. R-7541