

P-5430-2
Nov. 1964

UNITED STATES
DEPARTMENT OF THE INTERIOR
BUREAU OF LAND MANAGEMENT


SECTION DIAGRAM

MAP CONTRACT NO. 14-11-0001()-

T. 15 S. R. 23 E. SEC. 22, Will. MER. Prineville DISTRICT

MAPPER _____

DATE _____

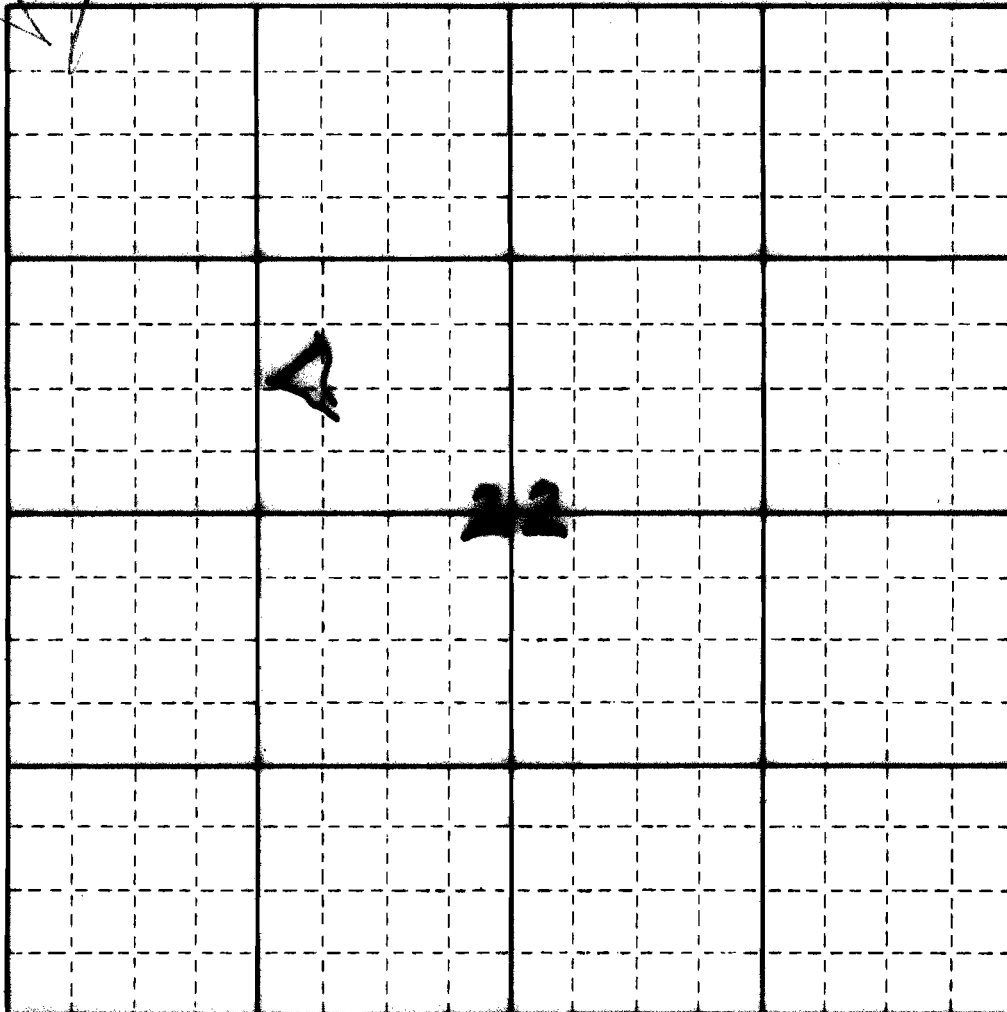

SCALE: 1" = 1,000 FT.

LEGEND

☐
☐
☐
☐
☐

RECEIVED

NOV 14 1973

STATE ENGINEER
SALEM, OREGON

☐
☐
☐
☐
☐

MAINLINE ROAD

PROPOSED SPUR ROADS

YARDING ROADS (CAT OR HIGH LEAD)

SPUR TREES (YARDING OR LOADING)

CORNERS FOUND

BOUNDARY - CONTRACT AREA

BOUNDARY - CUTTING AREA


Application No. R-5447
Permit No. R-7564

P-5430-2
Nov. 1964

UNITED STATES
DEPARTMENT OF THE INTERIOR
BUREAU OF LAND MANAGEMENT

SECTION DIAGRAM

____ MAP CONTRACT NO. 14-11-0001()-
T. 15 S. R. 23 E. SEC. 22, Will. MER. Prineville DISTRICT
MAPPER _____ DATE _____

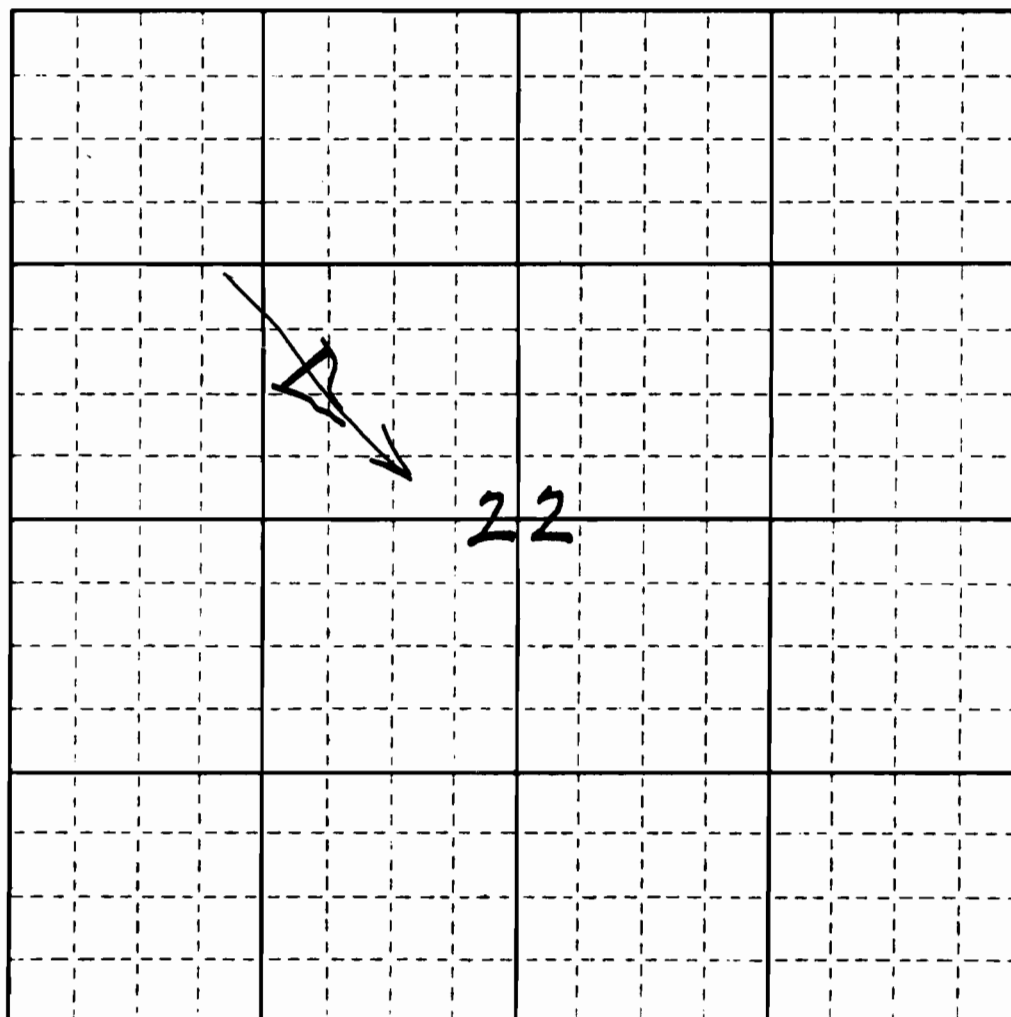

Application No. R-5449
Permit No. R 7564

SCALE: 1" = 1,000 FT.

LEGEND

	MAINLINE ROAD
	PROPOSED SPUR ROADS
	YARDING ROADS (CAT OR HIGH LEAD)
	SPUR TREES (YARDING OR LOADING)
	CORNERS FOUND
	BOUNDARY - CONTRACT AREA

RECEIVED

NOV 14 1973

STATE ENGINEER
SALEM, OREGON