P-5430-2
Nov. 1964

UNITED STATES
DEPARTMENT OF THE INTERIOR
BUREAU OF LAND MANAGEMENT

SECTION DIAGRAM

_____ MAP CONTRACT No. 14-11-0001( )-

T. 16 S. R. 23 E. SEC. 12 , Will. MER. Prineville DISTRICT

MAPPER _____ DATE _____

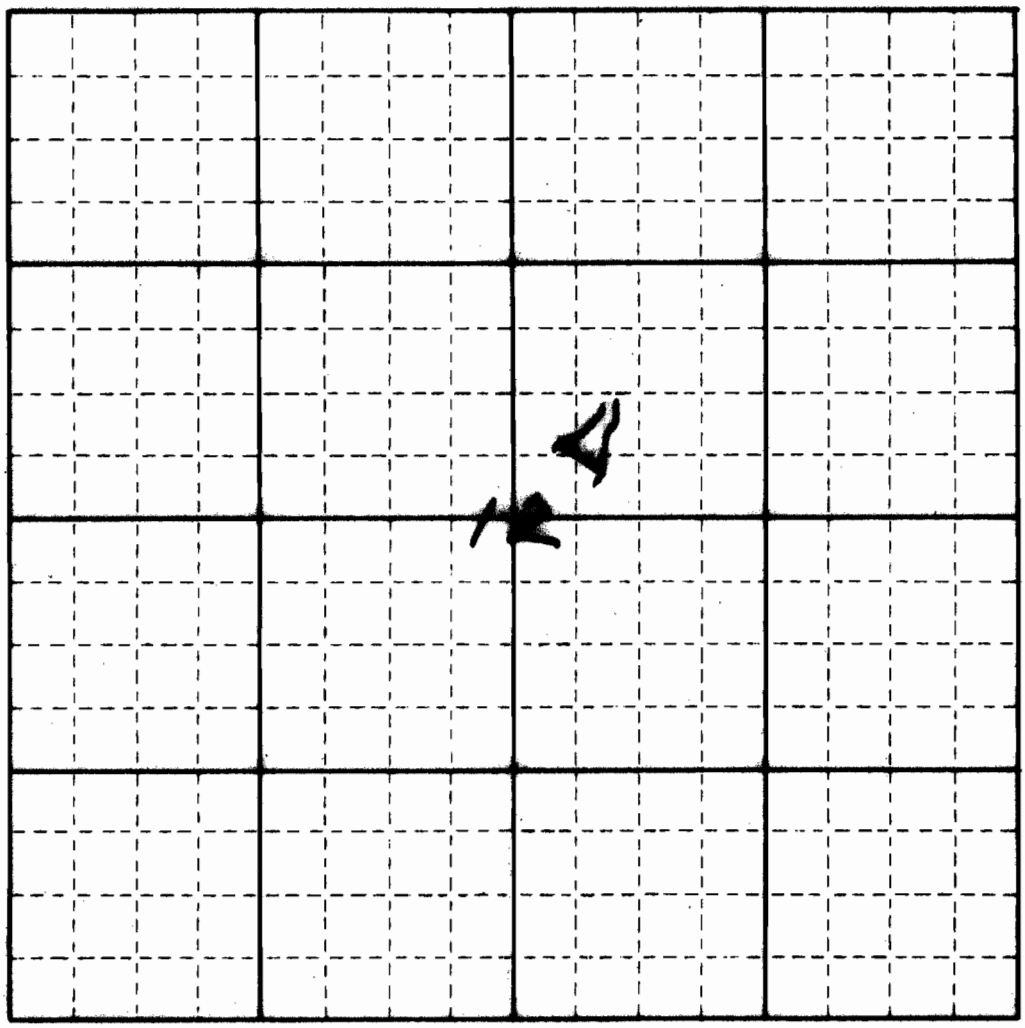

Application No. R-5146
Permit No. 7578

SCALE: 1" = 1,000 FT.

LEGEND

- MAINLINE ROAD
- PROPOSED SPUR ROADS
- YARDING ROADS (CAT OR HIGH LEAD)
- SPAR TREES (YARDING OR LOADING)
- CORNERS FOUND
- BOUNDARY - CONTRACT AREA
- BOUNDARY - CUTTING AREA

RECEIVED
NOV 14 1973
STATE ENGINEER
SALEM, OREGON