


P-5430-2
Nov. 1964

UNITED STATES
DEPARTMENT OF THE INTERIOR
BUREAU OF LAND MANAGEMENT

SECTION DIAGRAM

MAP CONTRACT NO. 14-11-0001()-
T. 17 S. R. 24 E. SEC. 16, Will. MER. Prineville DISTRICT
MAPPER _____ DATE _____

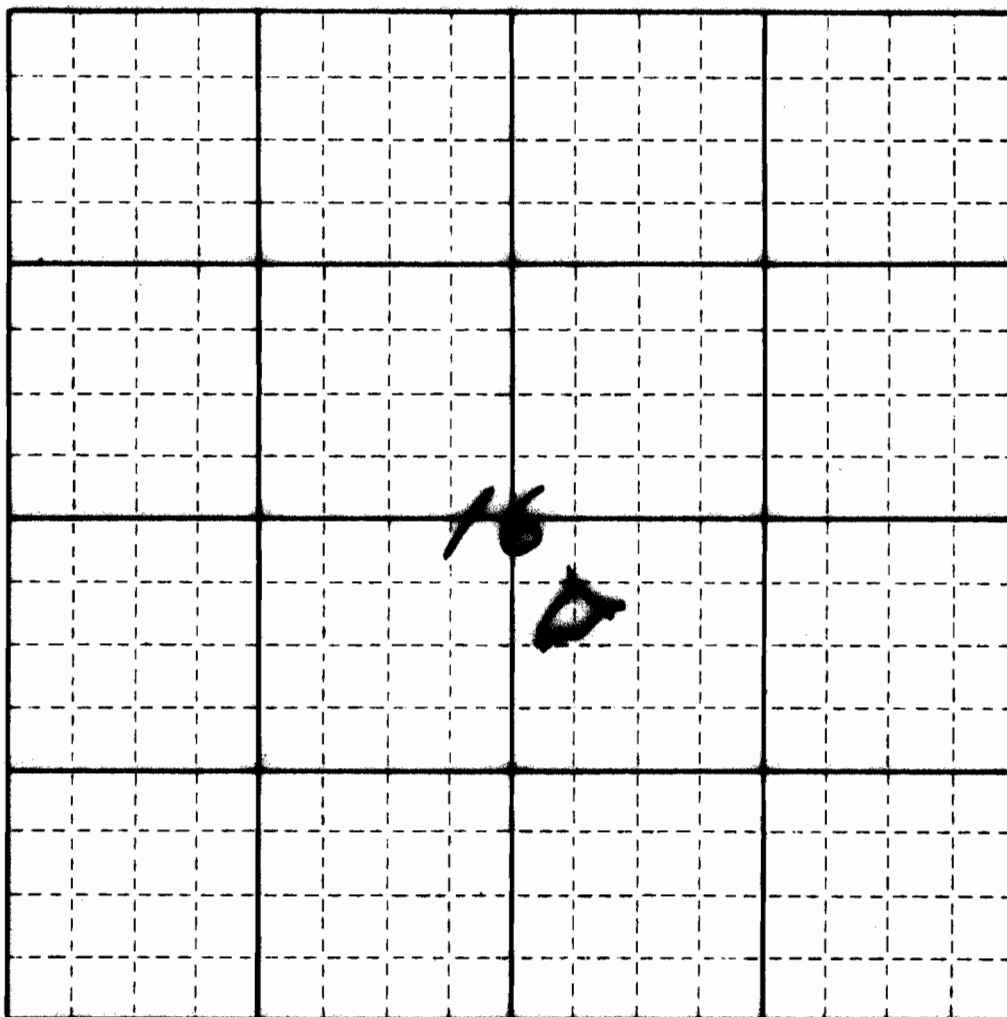

SCALE: 1" = 1,000 FT.

LEGEND

RECEIVED

NOV 14 1973

STATE ENGINEER
SALEM, OREGON

MAINLINE ROAD

PROPOSED SPUR ROADS

000000

YARDING ROADS (CAT OR HIGH LEAD)

SPUR TREES (YARDING OR LOADING)

CORNERS FOUND

BOUNDARY - CONTRACT AREA

BOUNDARY - CUTTING AREA

Application No. R-51472
 Permit No. R 7585