

P-5430-2
Nov. 1964


UNITED STATES
DEPARTMENT OF THE INTERIOR
BUREAU OF LAND MANAGEMENT

SECTION DIAGRAM

MAP CONTRACT No. 14-11-0001()-

T. 15 S., R. 22 E., SEC. 33, Will. MER. Prineville DISTRICT

MAPPER _____ DATE _____

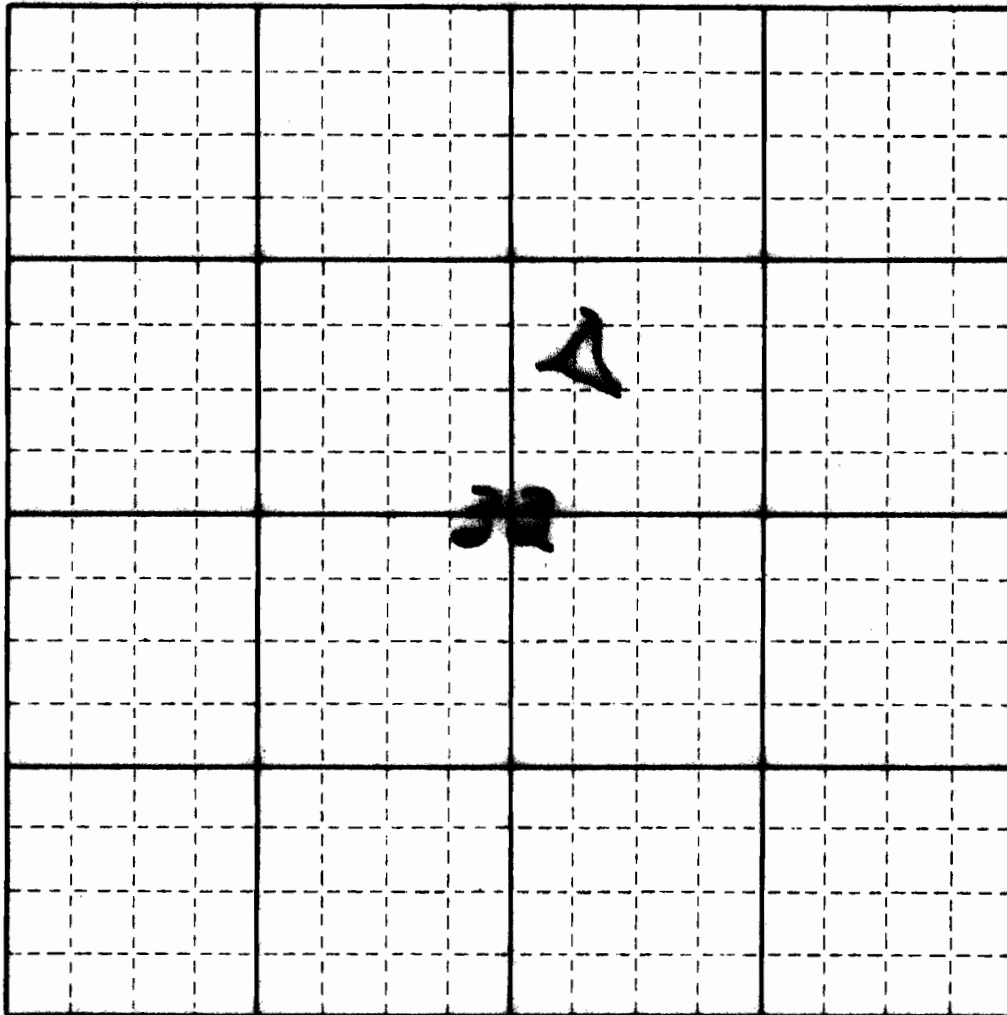

Permit No. R-514710
E 7589

SCALE: 1" = 1,000 FT.

LEGEND

- | | | | |
|--|-------|--|----------------------------------|
| | _____ | | MAINLINE ROAD |
| | _____ | | PROPOSED SPUR ROADS |
| | _____ | | YARDING ROADS (CAT OR HIGH LEAD) |
| | _____ | | SPUR TREES (YARDING OR LOADING) |
| | _____ | | CORNERS FOUND |
| | _____ | | BOUNDARY - CONTRACT AREA |
| | _____ | | BOUNDARY - CUTTING AREA |

RECEIVED
NOV 14 1973
STATE ENGINEER
SALEM, OREGON