

UNITED STATES
DEPARTMENT OF THE INTERIOR
BUREAU OF LAND MANAGEMENT

SECTION


Oregon State Water Filings

SW 1/4 NW 1/4 Sec 26

TOWNSHIP 17S, RANGE 22E, W. M.

FILED
1978
NOV 20
N

North

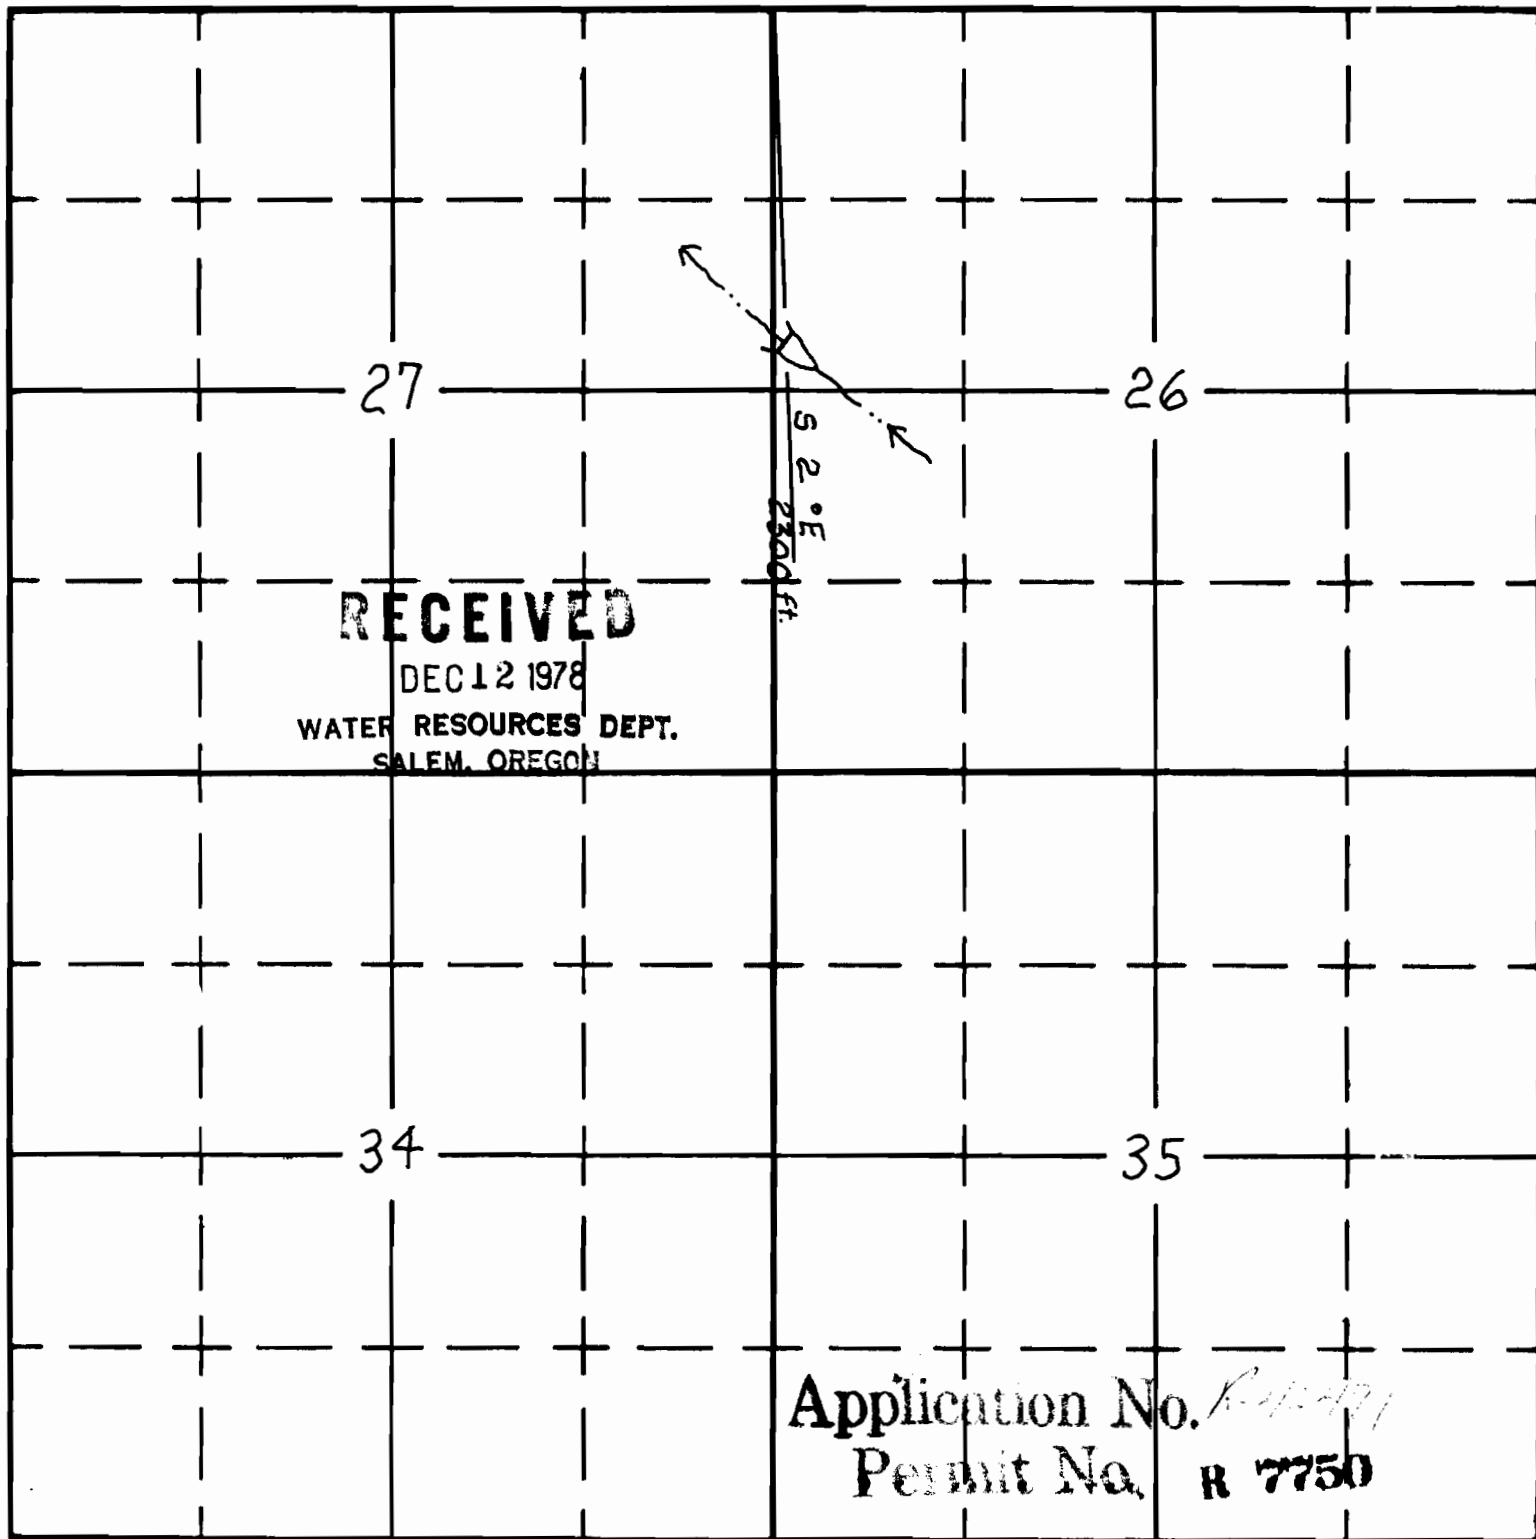

RECEIVED

DEC 12 1978

WATER RESOURCES DEPT.
SALEM, OREGON

Application No. R-42491
Permit No. **R 7750**

South

Twin Buttes Res.
05-R-236

APPLICATION No.
PERMIT No.