

Form A1-187
March 1961

UNITED STATES
DEPARTMENT OF THE INTERIOR
BUREAU OF LAND MANAGEMENT


SECTION

Oregon State Water Filings

NW 1/4 SE 1/4 Sec 33

TOWNSHIP 19 S, RANGE 21 E, W. M.

North

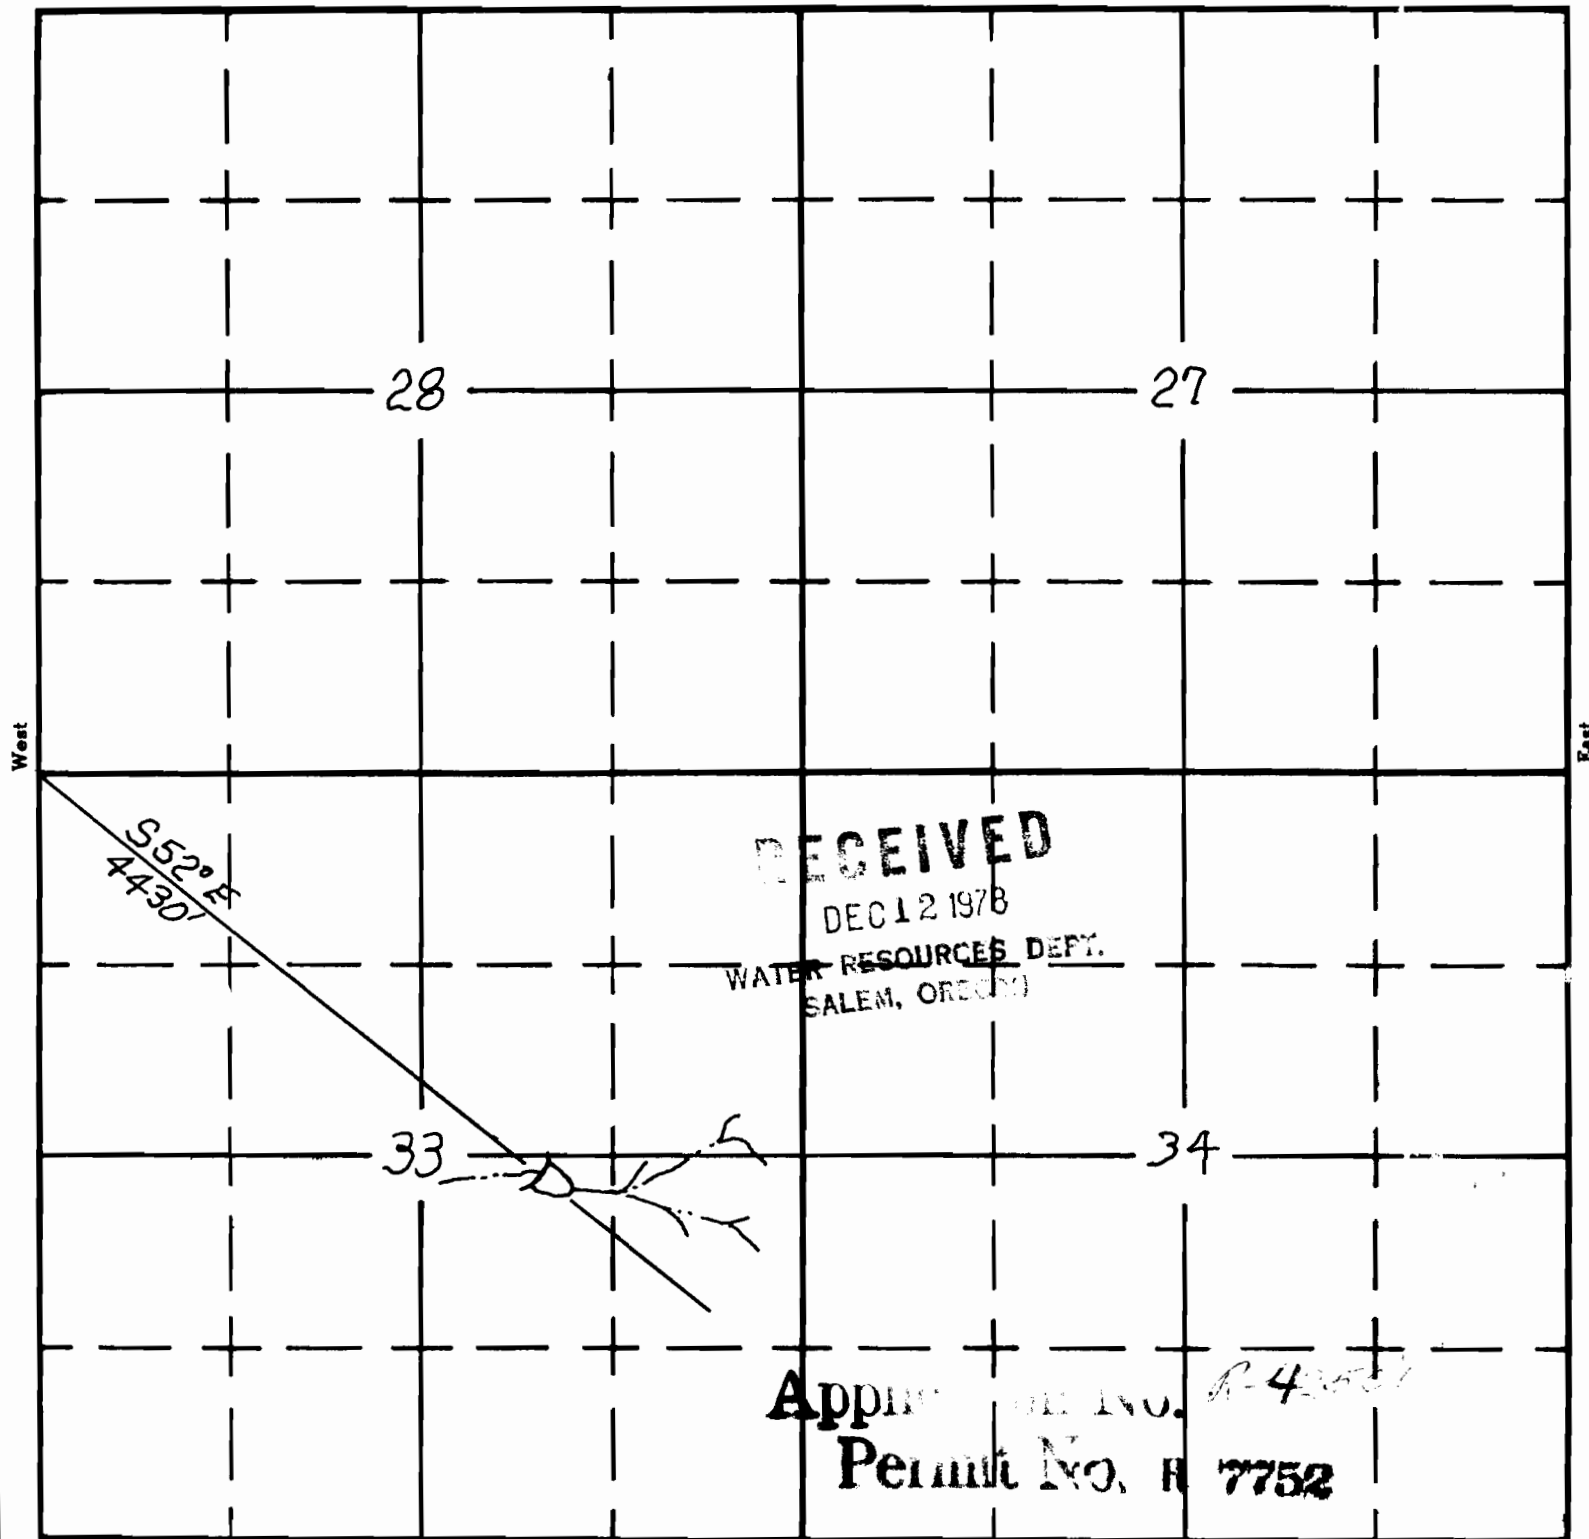

South

South Clover Res. #1
05-R-252

APPLICATION No.
PERMIT No.