Form A1-187
March 1961

UNITED STATES
DEPARTMENT OF THE INTERIOR
BUREAU OF LAND MANAGEMENT

SECTION
SE¼ SE¼ Sec 1

Oregon State Water Filings

TOWNSHIP 19S, RANGE 20E, W. M.

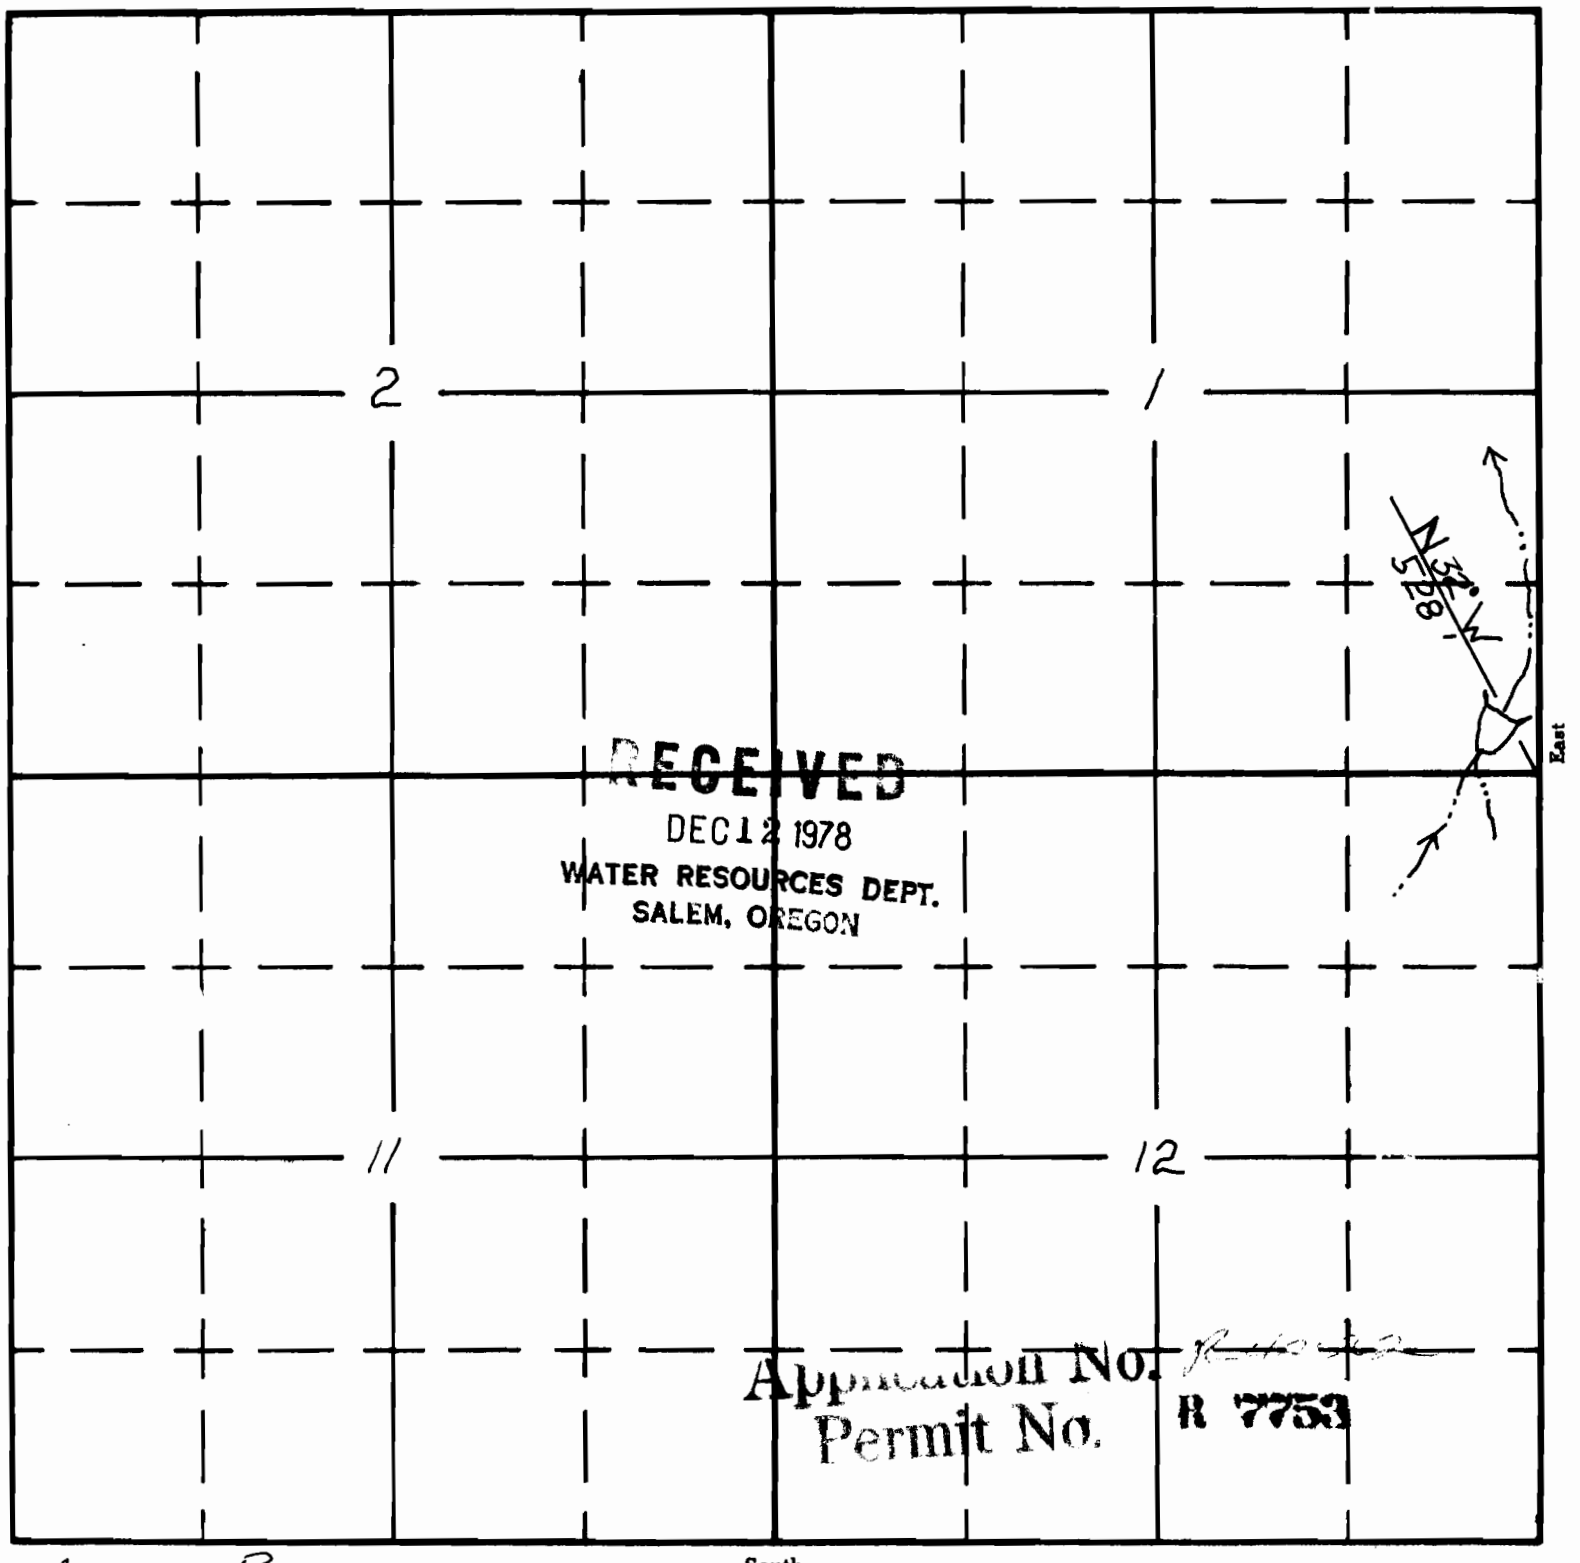

RECEIVED
DEC 12 1978
WATER RESOURCES DEPT.
SALEM, OREGON

Application No. R 7753
Permit No.

Ammons Res.
05-R-259

APPLICATION No.
PERMIT No.