

UNITED STATES
DEPARTMENT OF THE INTERIOR
BUREAU OF LAND MANAGEMENT

SECTION


5

Oregon State Water Filings

NE 1/4 SE 1/4

TOWNSHIP 18S, RANGE 22E, W. M.

North

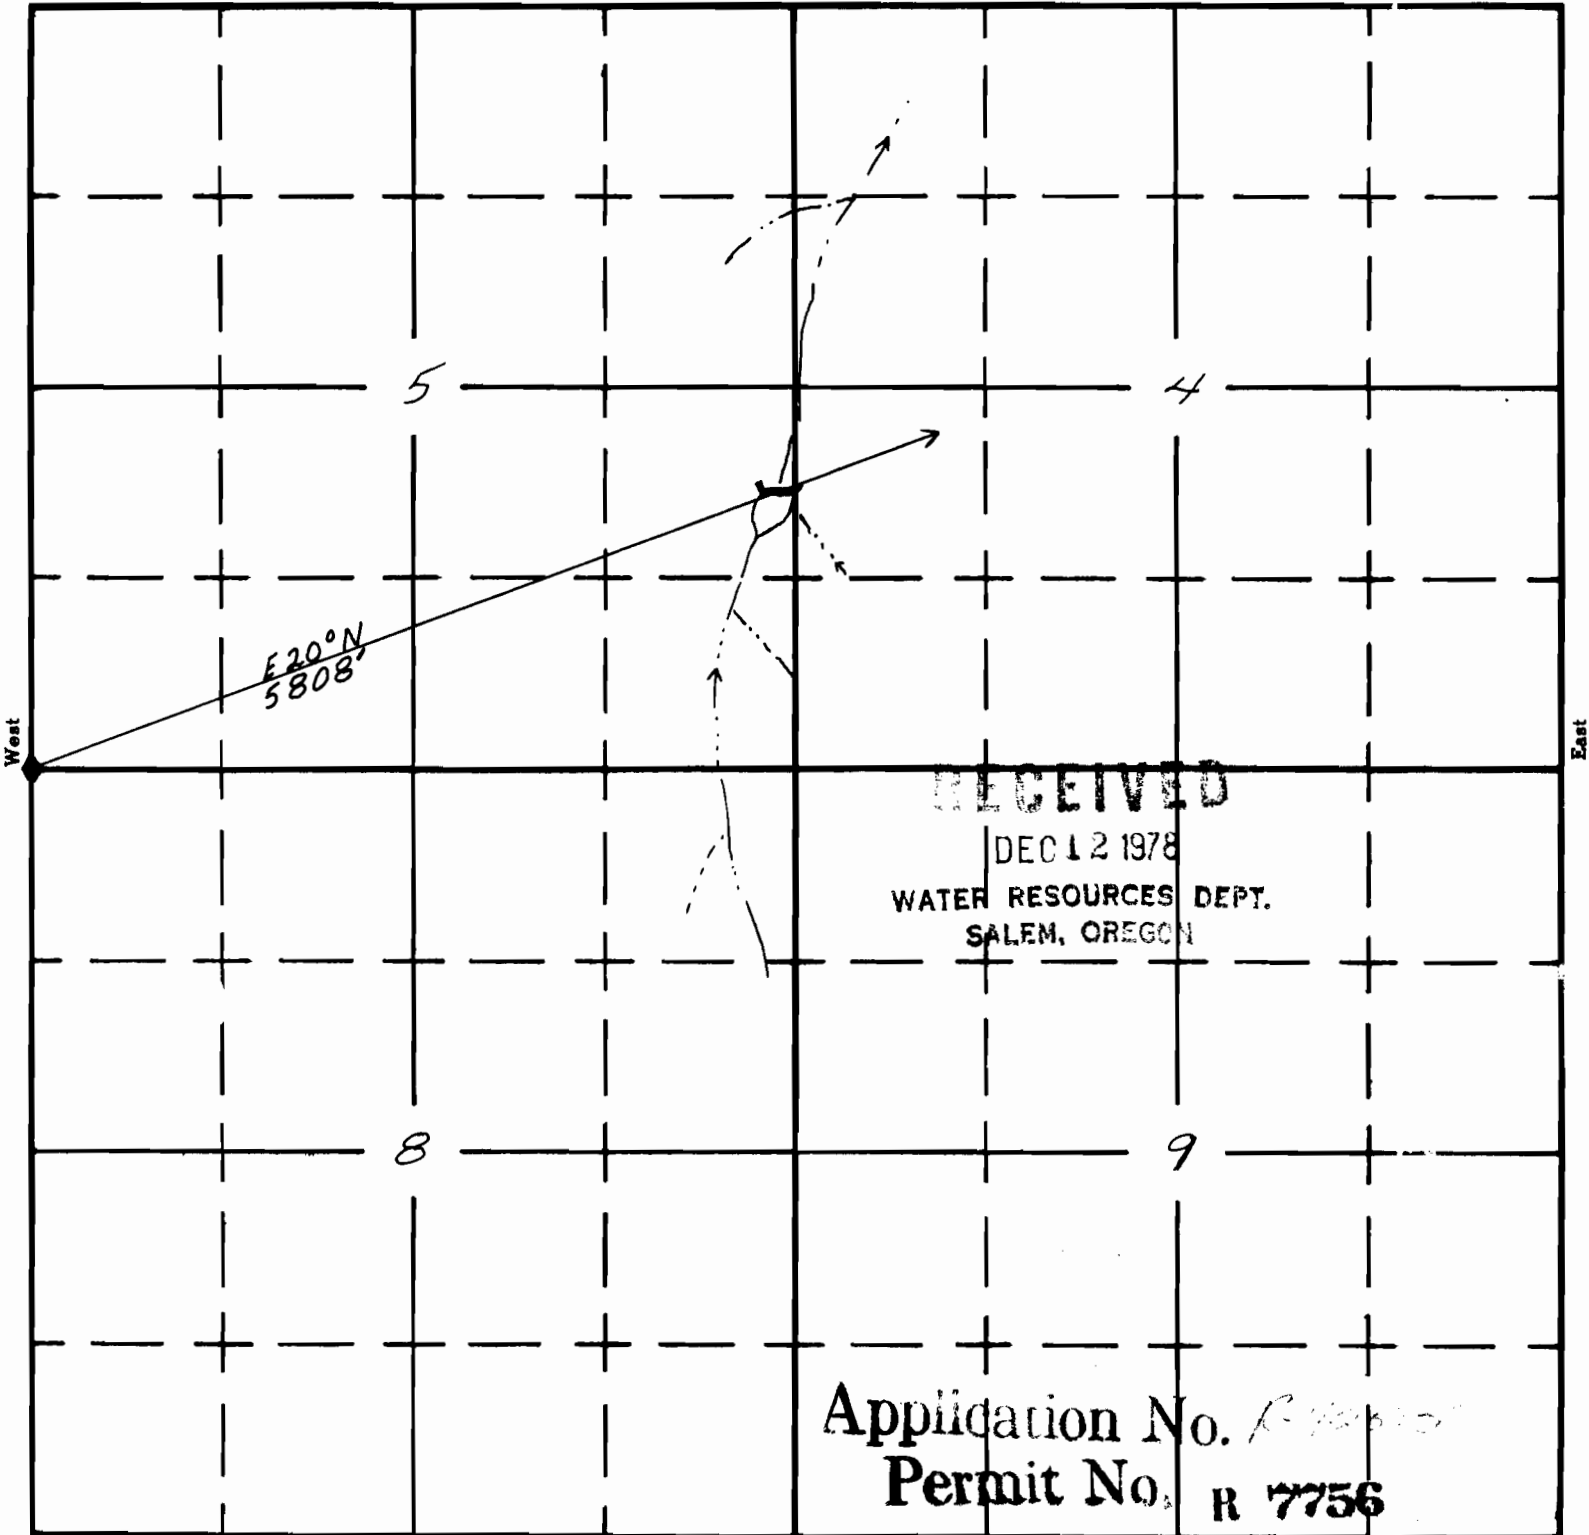

upper Table Res. # 3
05-R-232

South

APPLICATION No.
PERMIT No.