

Form AI-187
March 1961

UNITED STATES
DEPARTMENT OF THE INTERIOR
BUREAU OF LAND MANAGEMENT

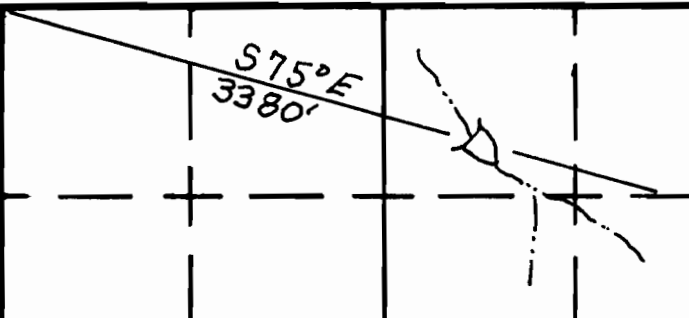
SECTION

NW $\frac{1}{4}$ NE $\frac{1}{4}$ Sec 18

Oregon State Water Filings

TOWNSHIP 18S, RANGE 22E, W. M.

North

			
18		17	
		RECEIVED DEC 12 1978 WATER RESOURCES DEPT. SALEM, OREGON	
19		20	
		Application No. <u>R-47506</u> Permit No. <u>R 7757</u>	

Upper Table Res. #5
05-R-234

South

APPLICATION No.
PERMIT No.