

Form AI-187
March 1961

UNITED STATES
DEPARTMENT OF THE INTERIOR
BUREAU OF LAND MANAGEMENT


SECTION

Oregon State Water Filings

SE 1/4 SE 1/4 Sec 4

TOWNSHIP 18S, RANGE 22E, W. M.

North

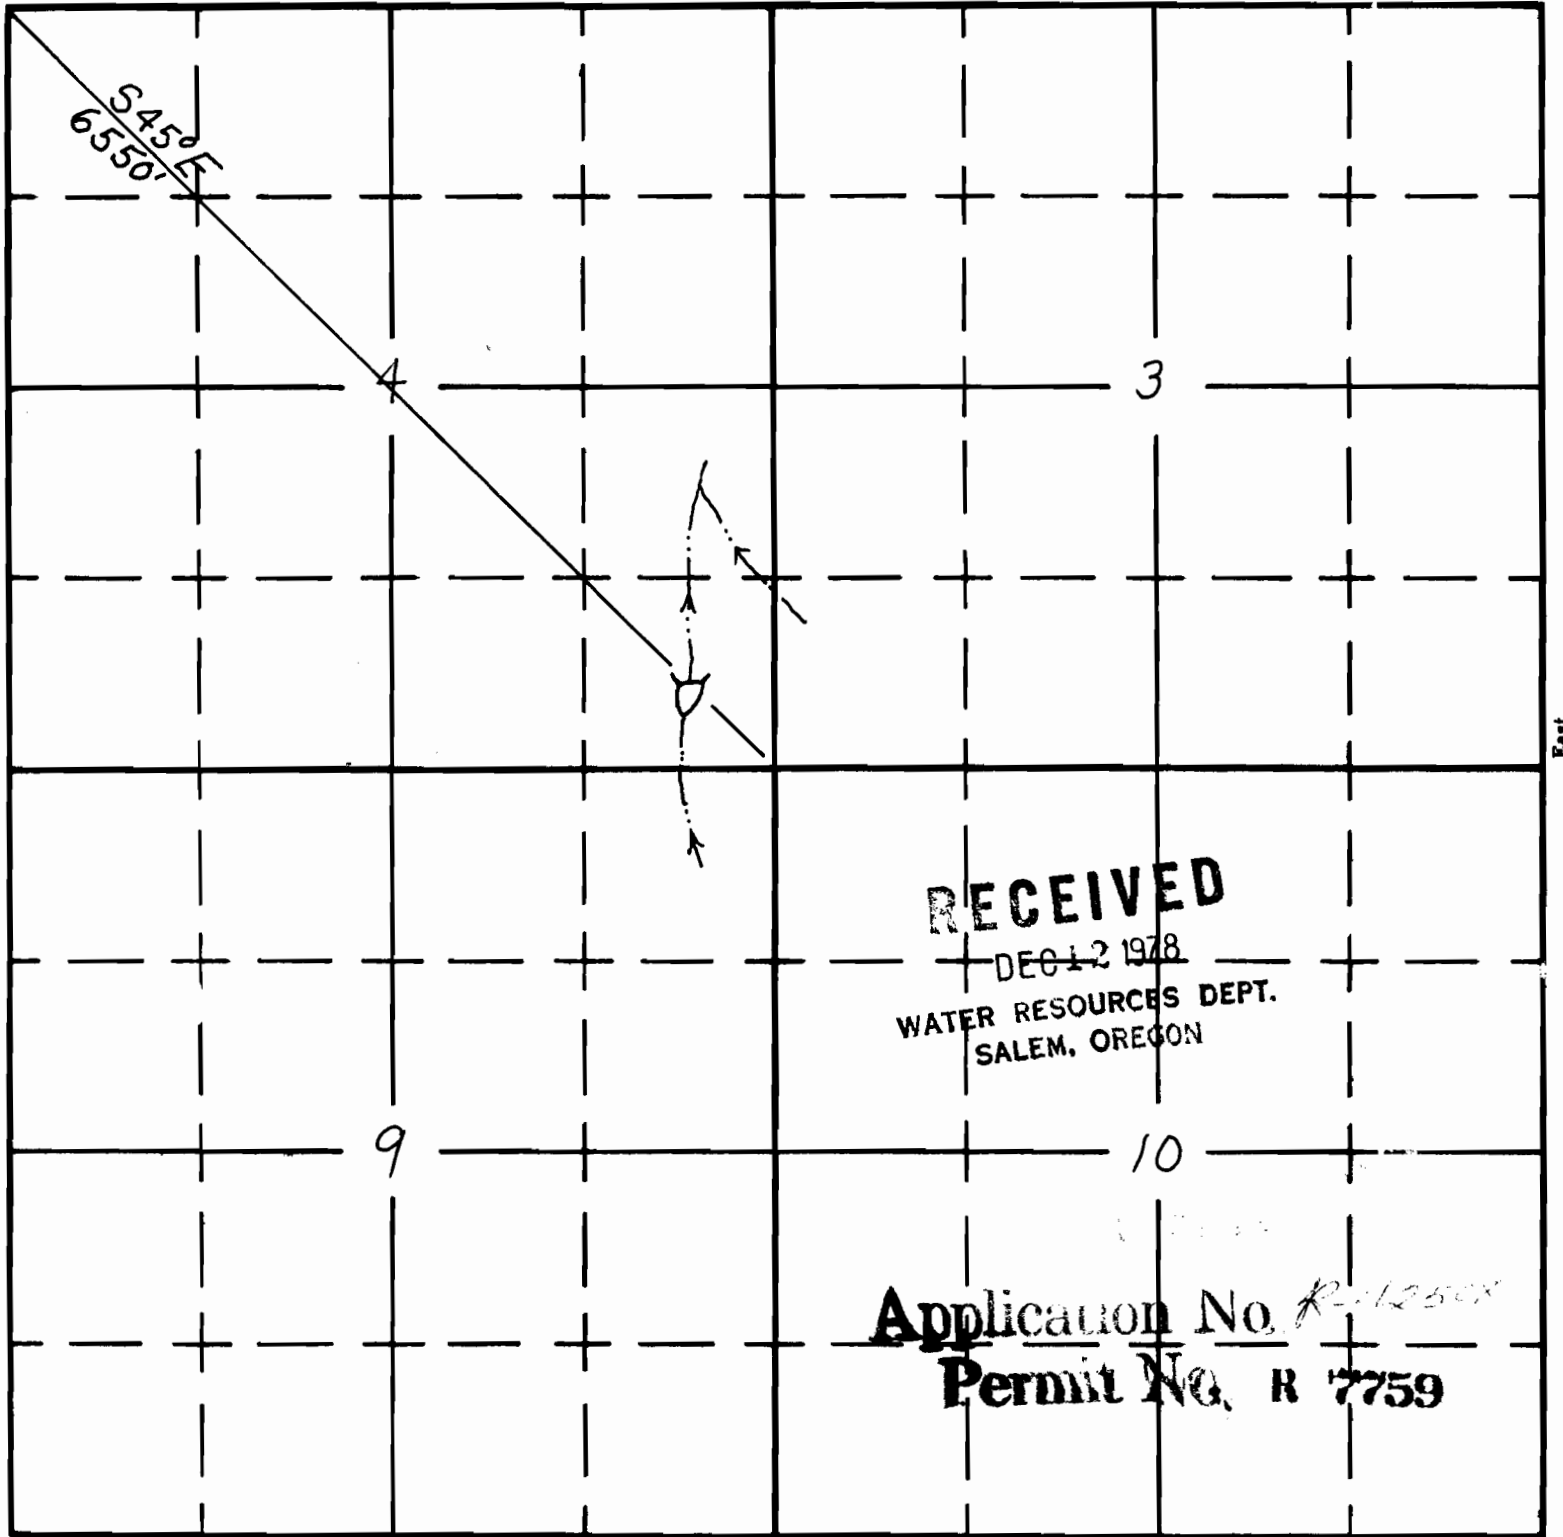

South

Upper Table Res #1
05-R-230

APPLICATION No.

PERMIT No.