


P-5430-2
Nov. 1964
(formerly AI-29)

UNITED STATES
DEPARTMENT OF THE INTERIOR
BUREAU OF LAND MANAGEMENT

0094


SECTION DIAGRAM

MAP CONTRACT No. 14-11-0001()-
T. 15 S., R. 23 E. SEC. 35, Will. MER. Prineville DISTRICT
MAPPER DATE

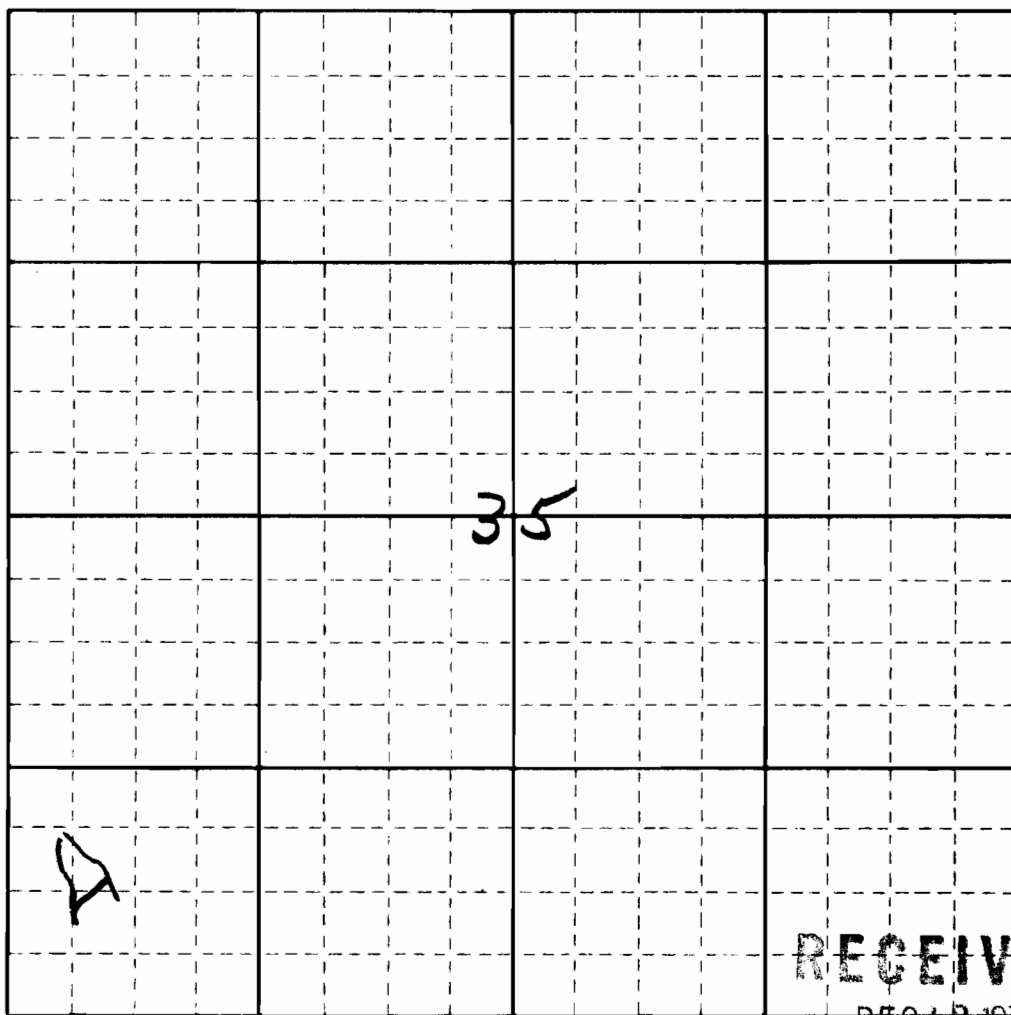

SCALE: 1" = 1,000 FT.

LEGEND

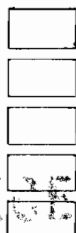

RECEIVED

NOV 14 1973

STATE ENGINEER
SALEM, OREGON

- WATER RESOURCES DEPT.
SALEM, OREGON
- MAINLINE ROAD
 - PROPOSED SPUR ROADS
 - YARDING ROADS (CAT OR HIGH LEAD)
 - SPUR TREES (YARDING OR LOADING)
 - CORNERS FOUND
 - BOUNDARY - CONTRACT AREA
 - BOUNDARY - CUTTING AREA