

UNITED STATES
DEPARTMENT OF THE INTERIOR
BUREAU OF LAND MANAGEMENT


SECTION

13
NE $\frac{1}{4}$ SE $\frac{1}{4}$

Oregon State Water Filings

TOWNSHIP 31 S, RANGE 29 E, W. M.

North

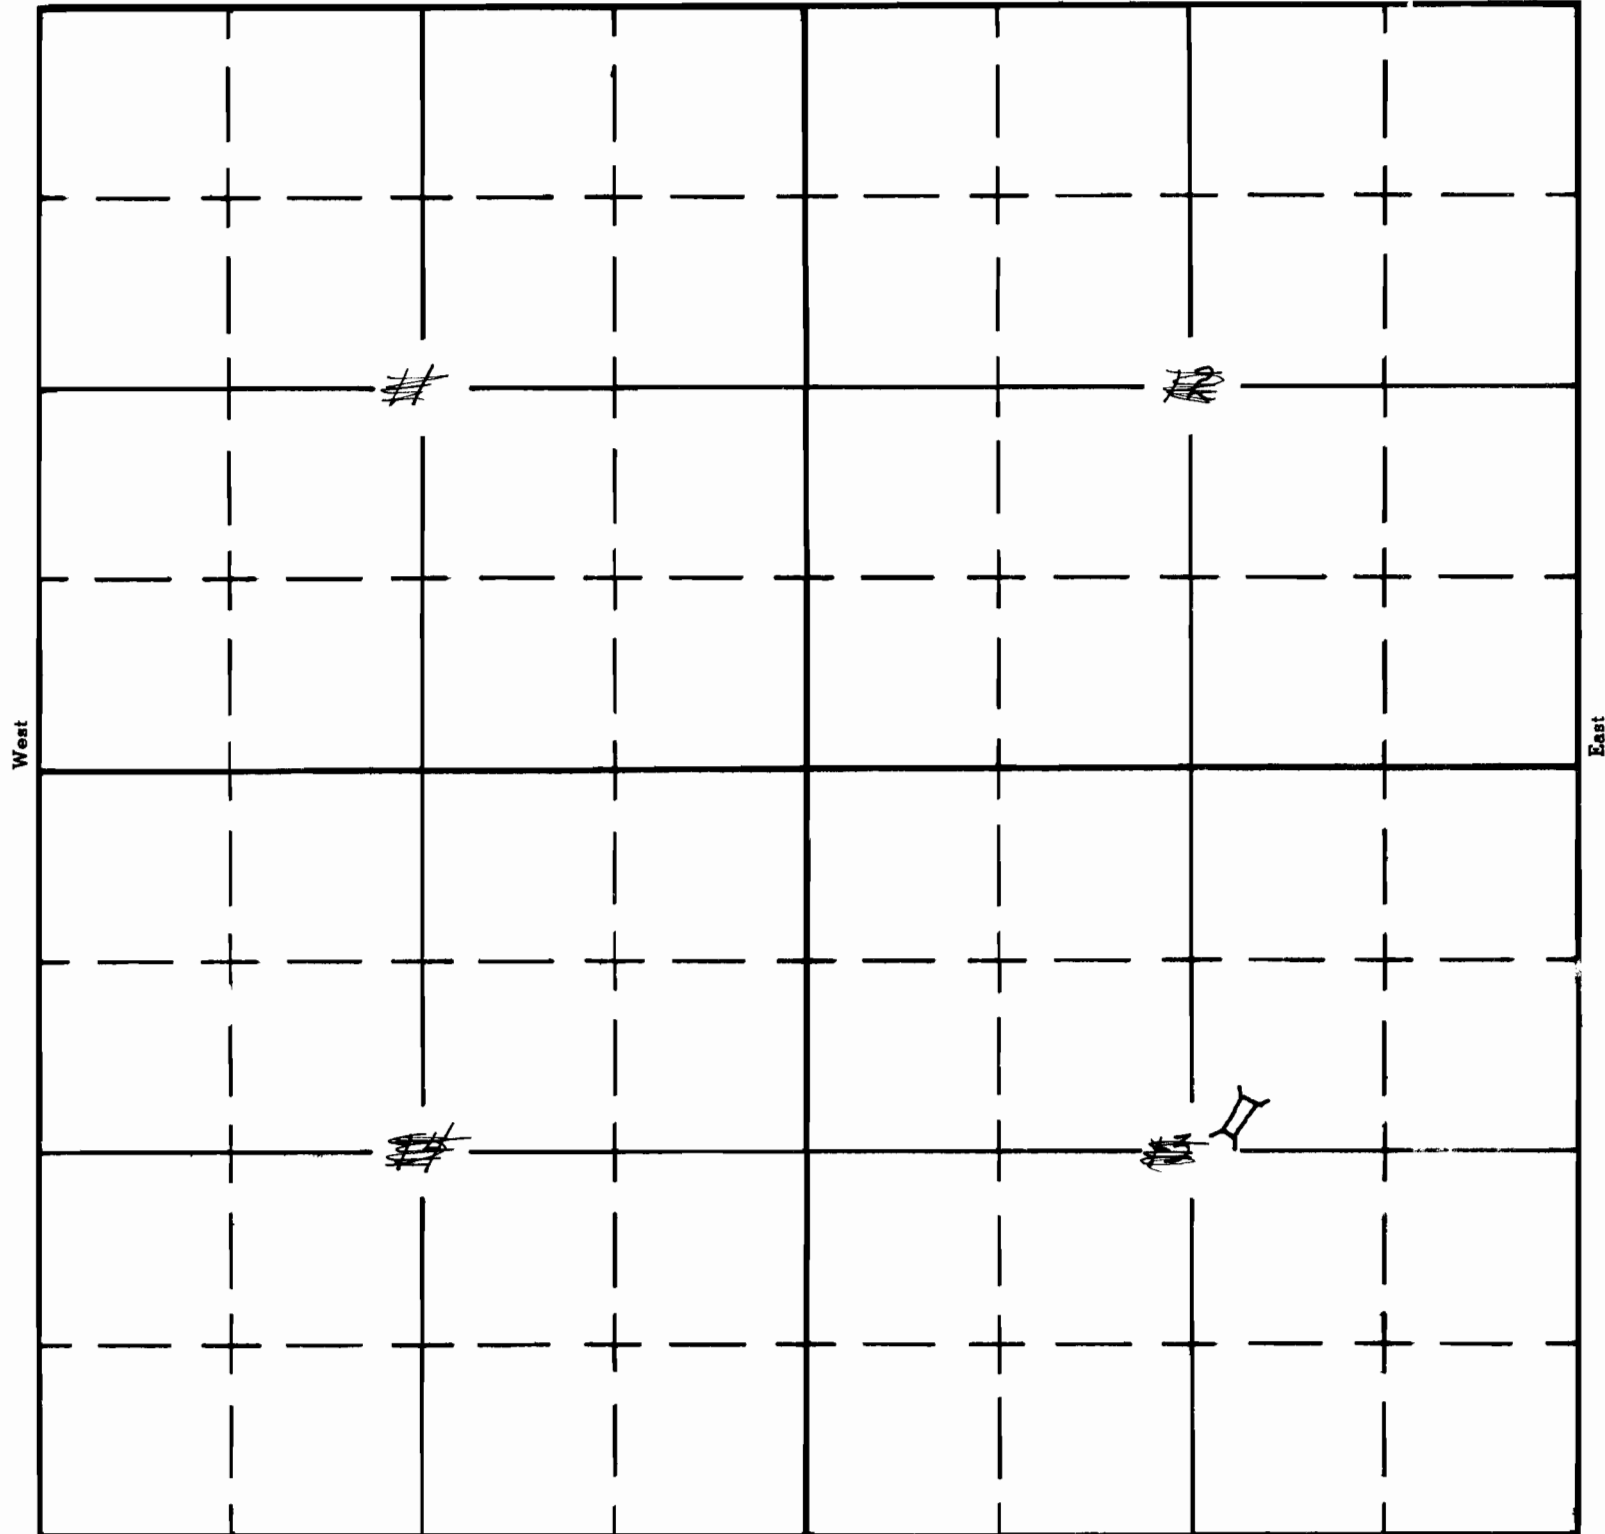

Application No. R-34252
Permit No. R-2490

APPLICATION No.
PERMIT No.


UNITED STATES
DEPARTMENT OF THE INTERIOR
BUREAU OF LAND MANAGEMENT

S. DN
13
NE 1/4 SE 1/4

Oregon State Water Filings

TOWNSHIP 31 S, RANGE 29 E, W. M.

North

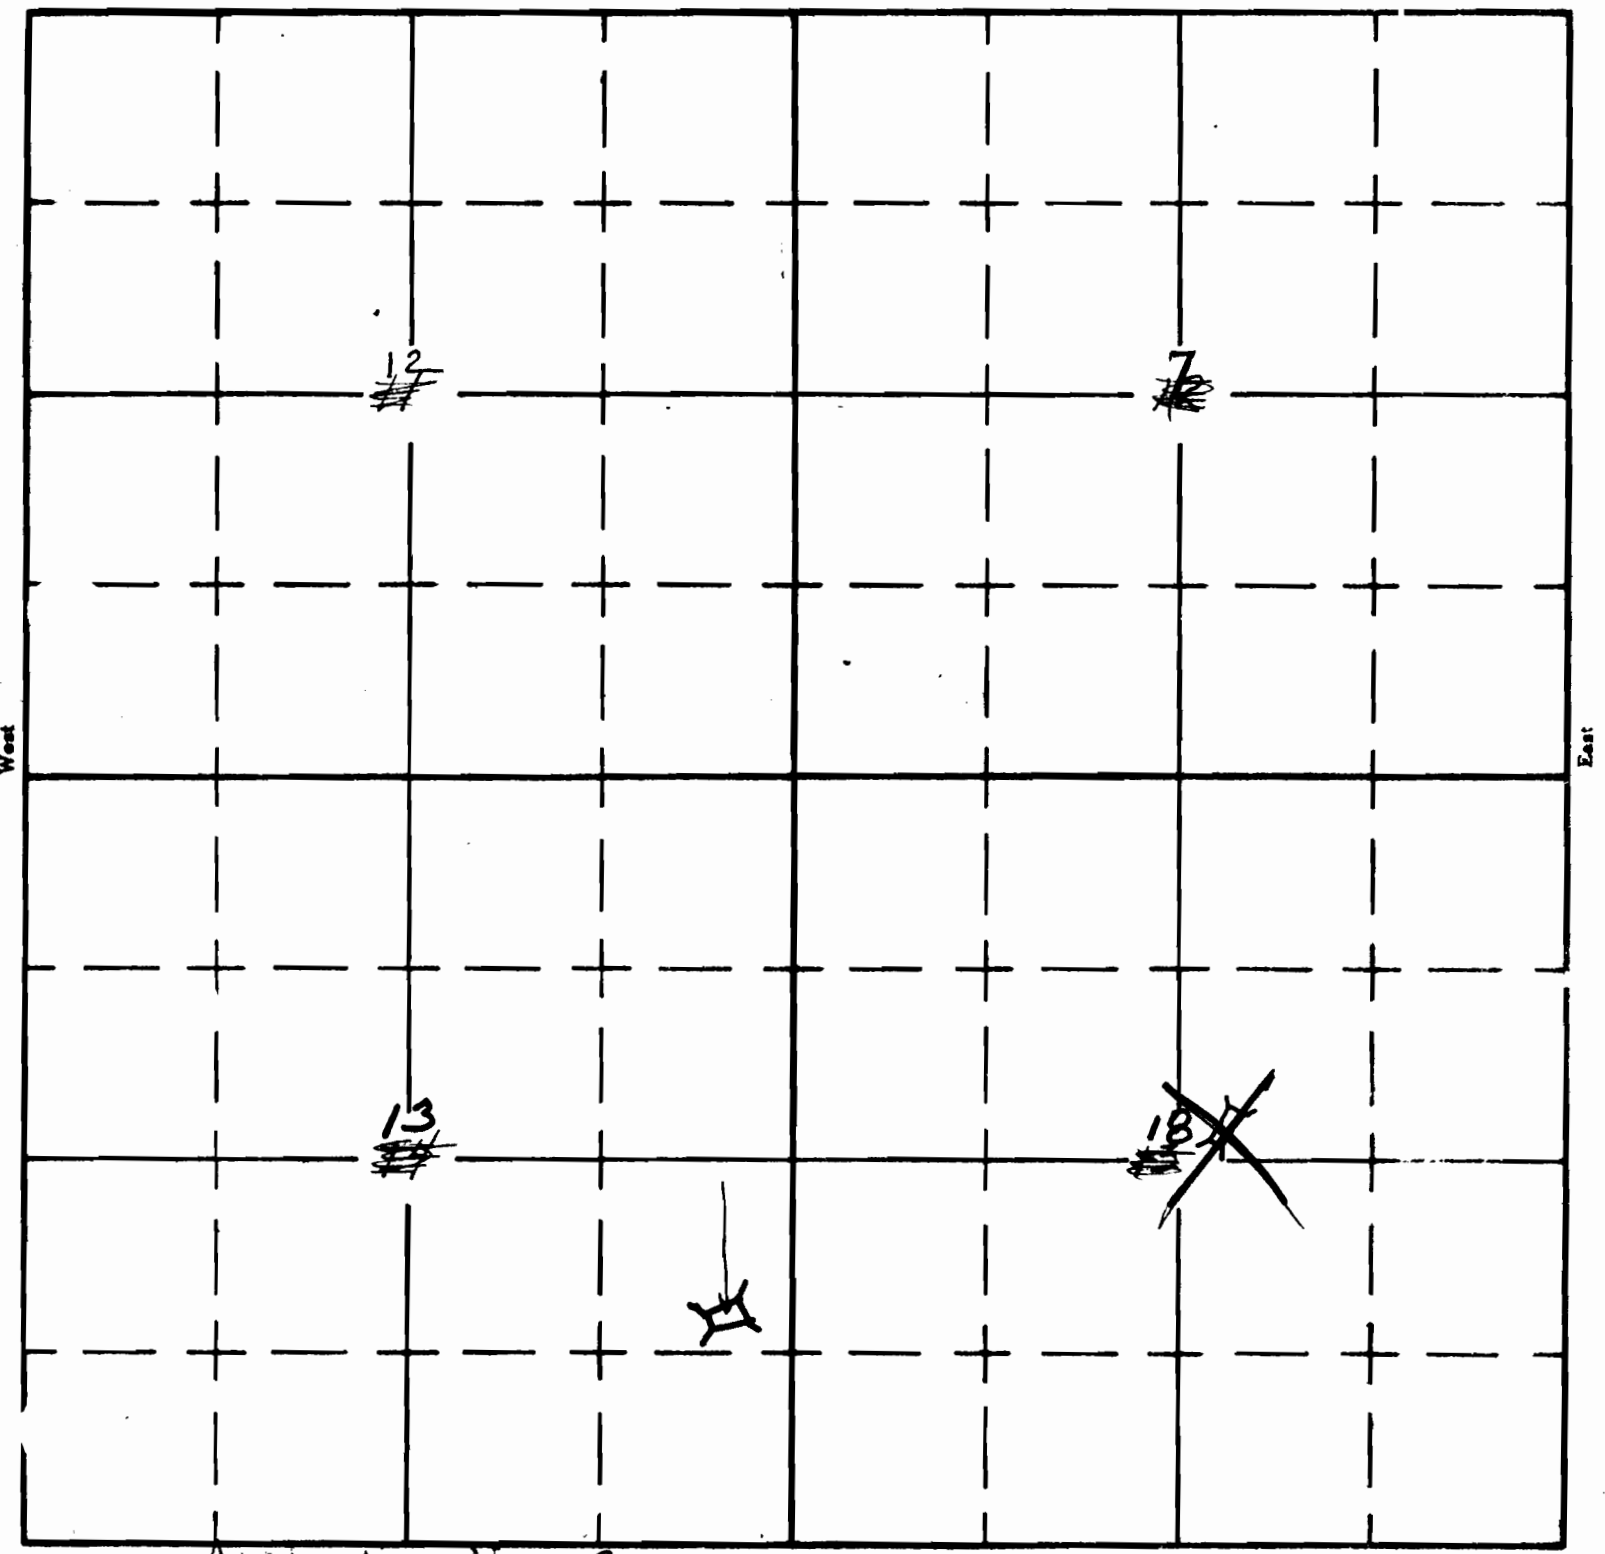

Application No. R-34252
Permit No. R-2490

APPLICATION No.
PERMIT No.