

UNITED STATES
DEPARTMENT OF THE INTERIOR
BUREAU OF LAND MANAGEMENT

SECTION

23 *

NE $\frac{1}{4}$ NE $\frac{1}{4}$

24 NW $\frac{1}{4}$ NW $\frac{1}{4}$

Oregon State Water Filings

TOWNSHIP 32 S, RANGE 30 E, W. M.

North

West

East

South

Application No. R-34258
Permit No. R-2496


APPLICATION No.
PERMIT No.

UNITED STATES
DEPARTMENT OF THE INTERIOR
BUREAU OF LAND MANAGEMENT

Oregon State Water Filings

TOWNSHIP 32 S, RANGE 30 E, W. M.

ION
23
~~NE NE~~
24 NW NW
SEC. 29
NW NW NW

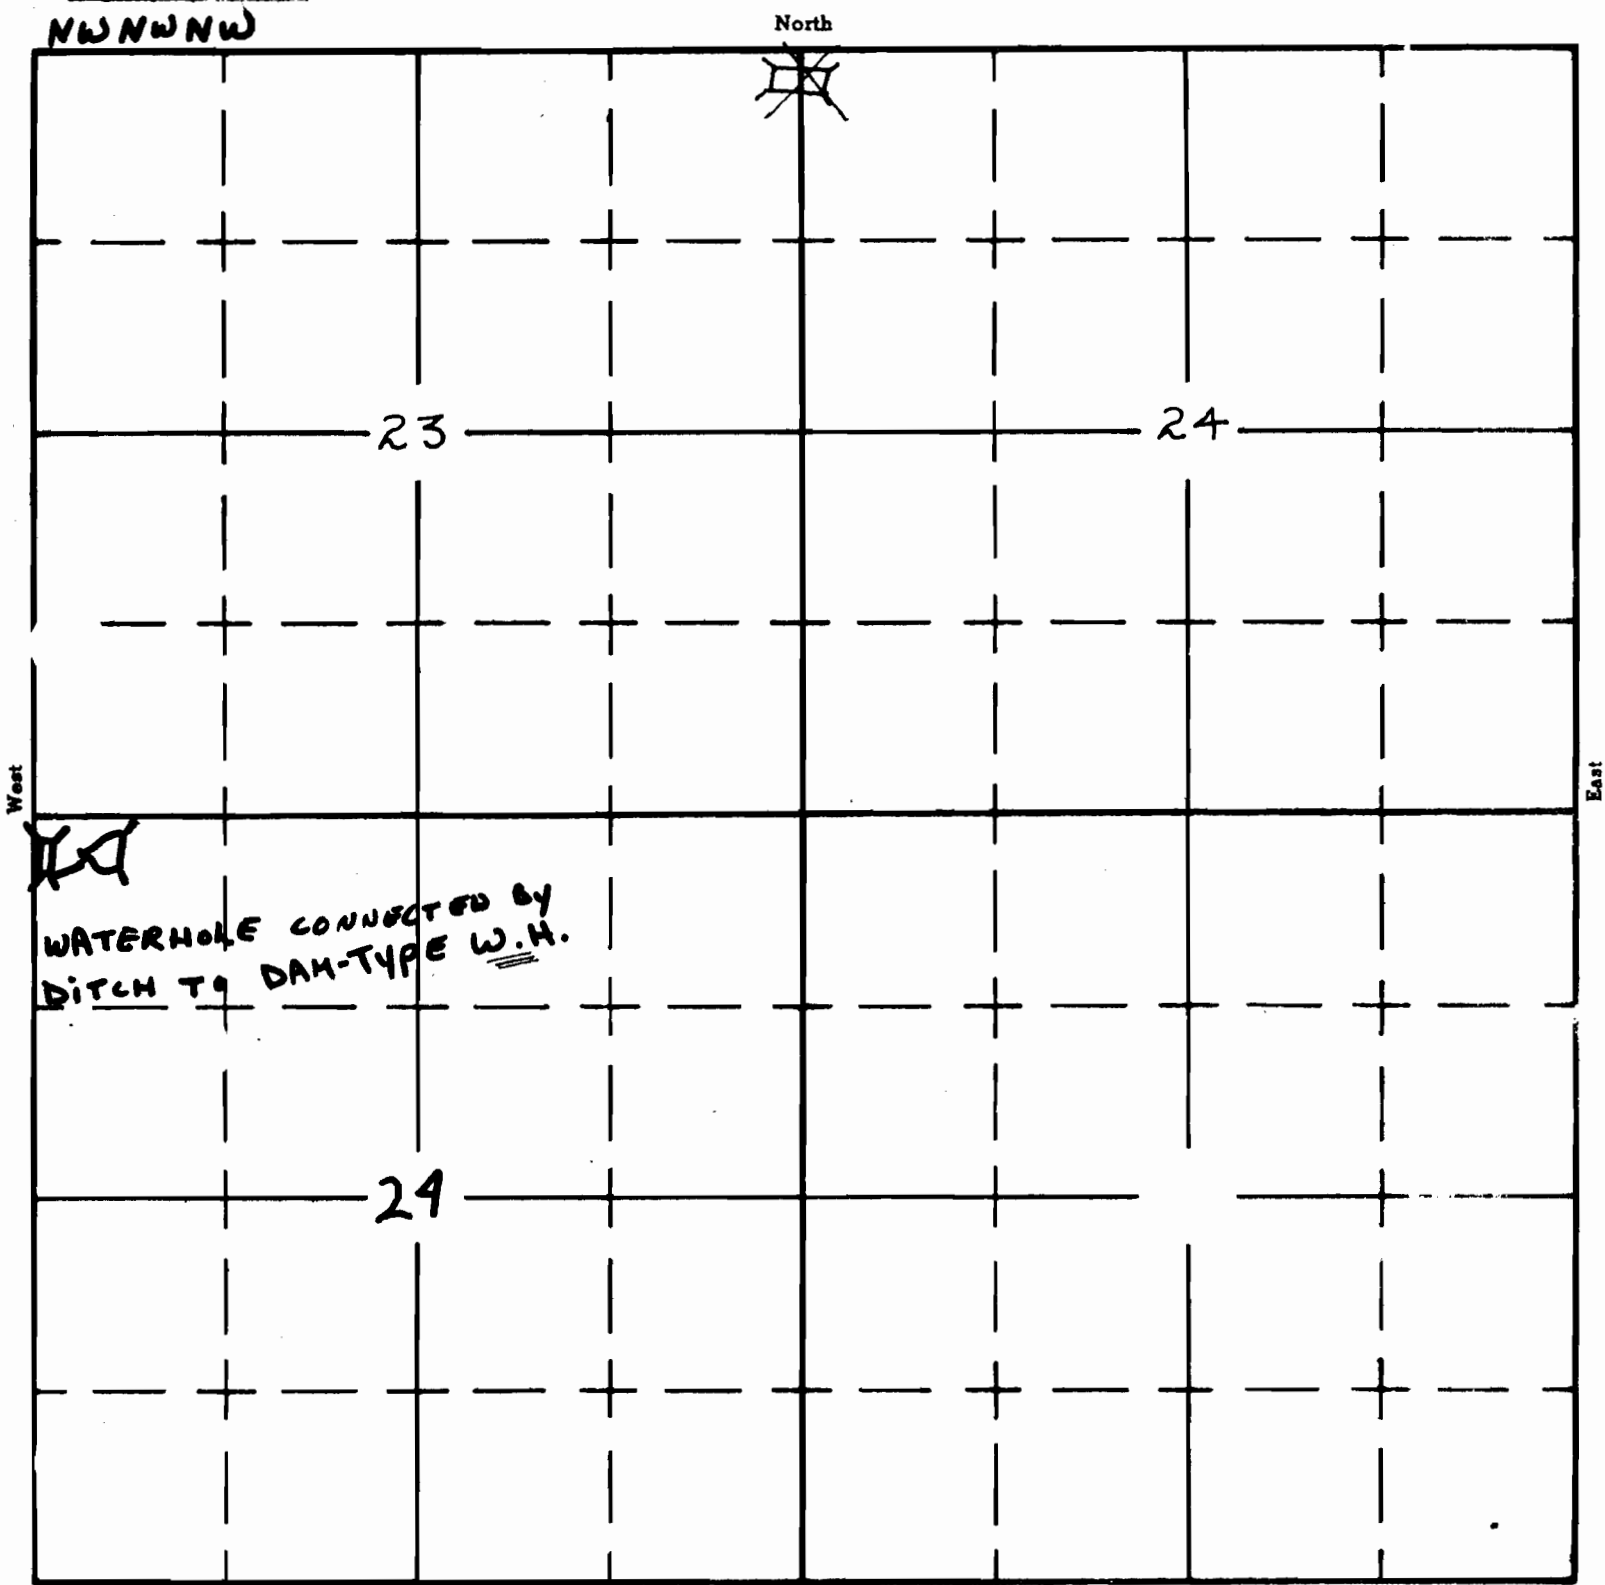

Application No. R-34258
Permit No. R-2491

APPLICATION No.
00000000