

UNITED STATES
DEPARTMENT OF THE INTERIOR
BUREAU OF LAND MANAGEMENT

SECTION


13

NW¹/₄ SE¹/₄

Oregon State Water Filings

TOWNSHIP 31S, RANGE 30E, W. M.

North

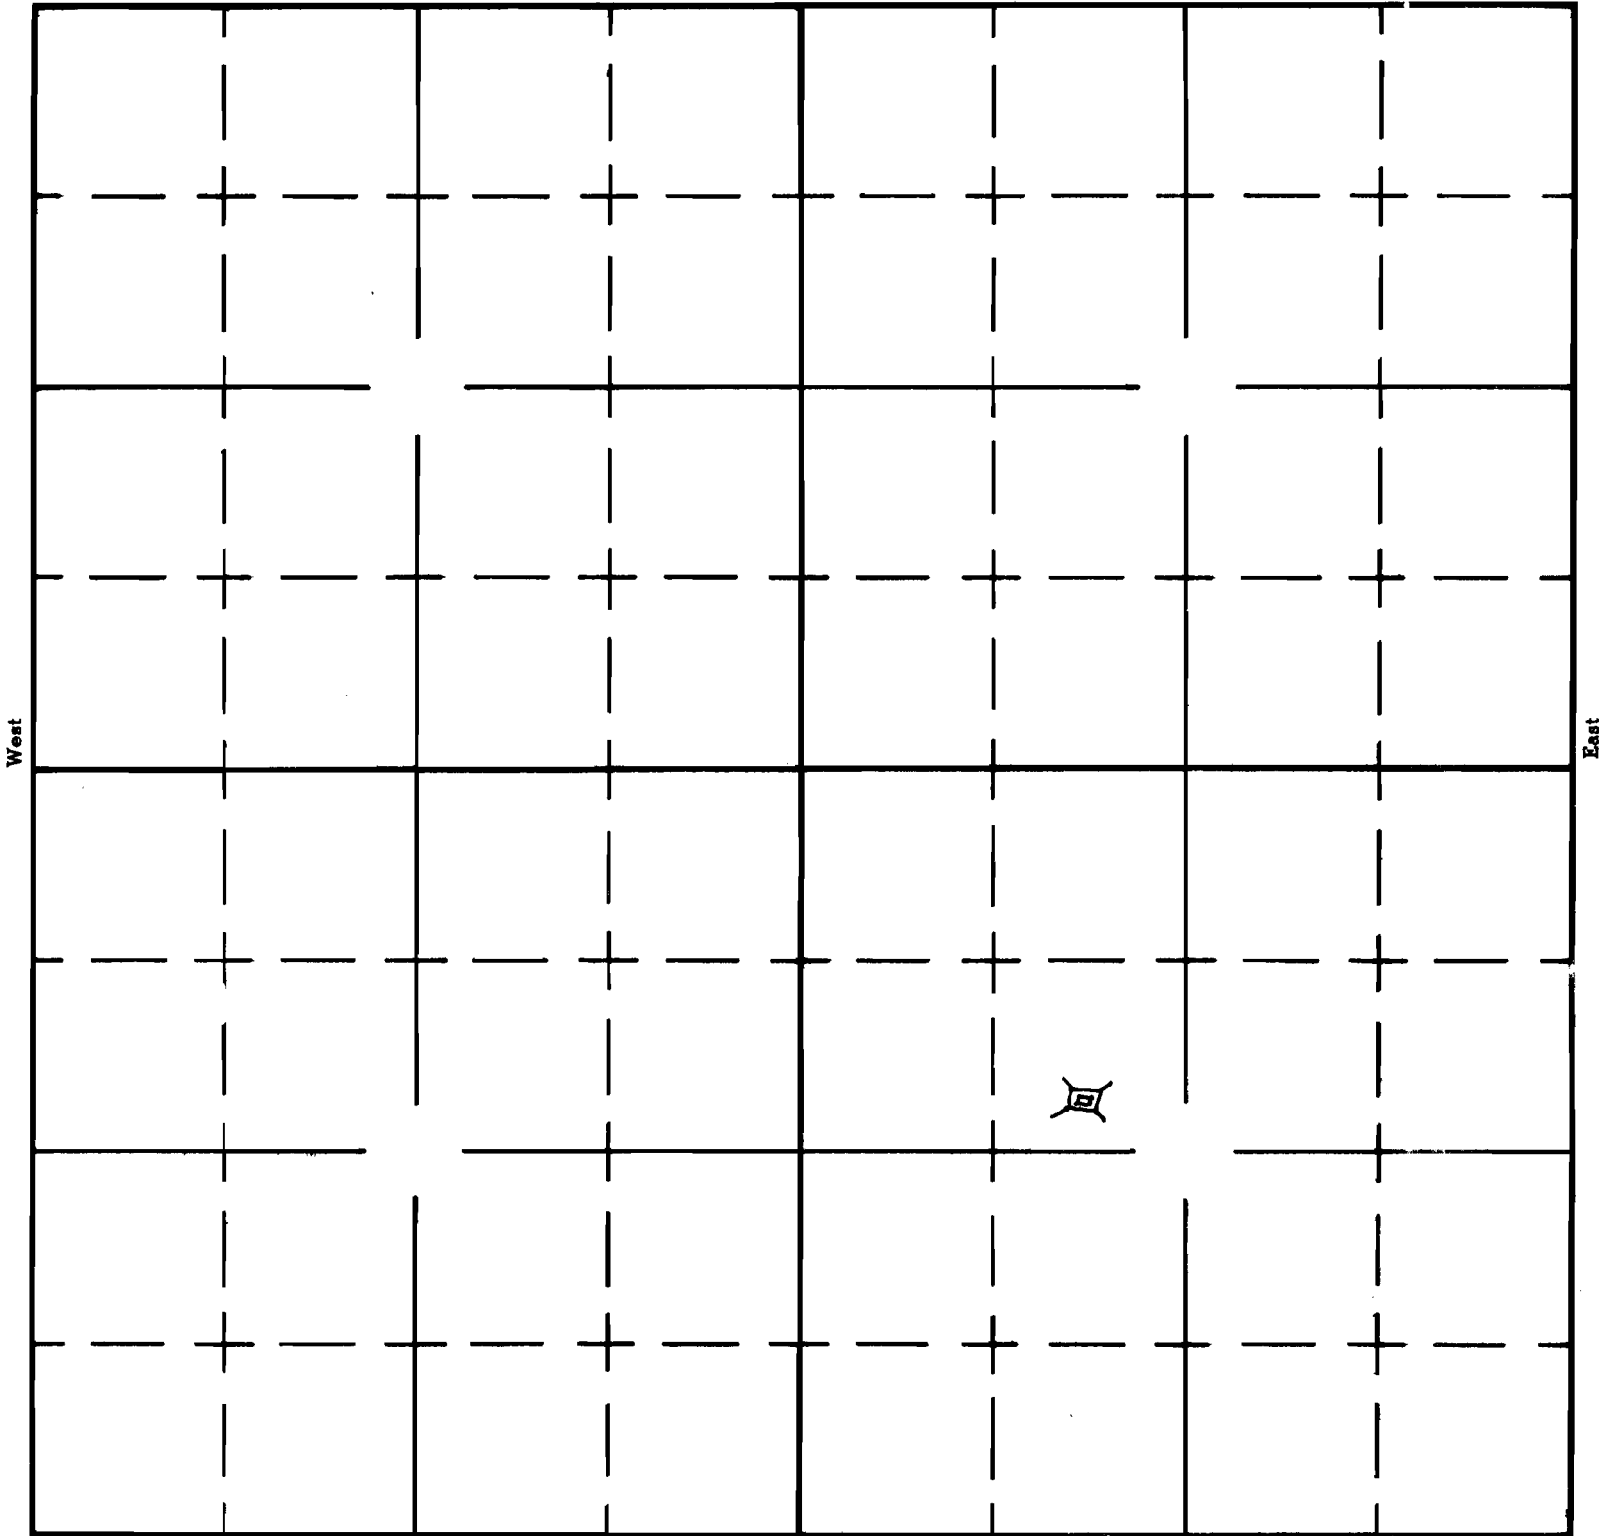

Application No. R-34259
Permit No. R-2497

APPLICATION No.
PERMIT No.

UNITED STATES
DEPARTMENT OF THE INTERIOR
BUREAU OF LAND MANAGEMENT


S. ON 13

NW 1/4 SE 1/4

Oregon State Water Filings

TOWNSHIP 31S, RANGE 30E, W. M.

North

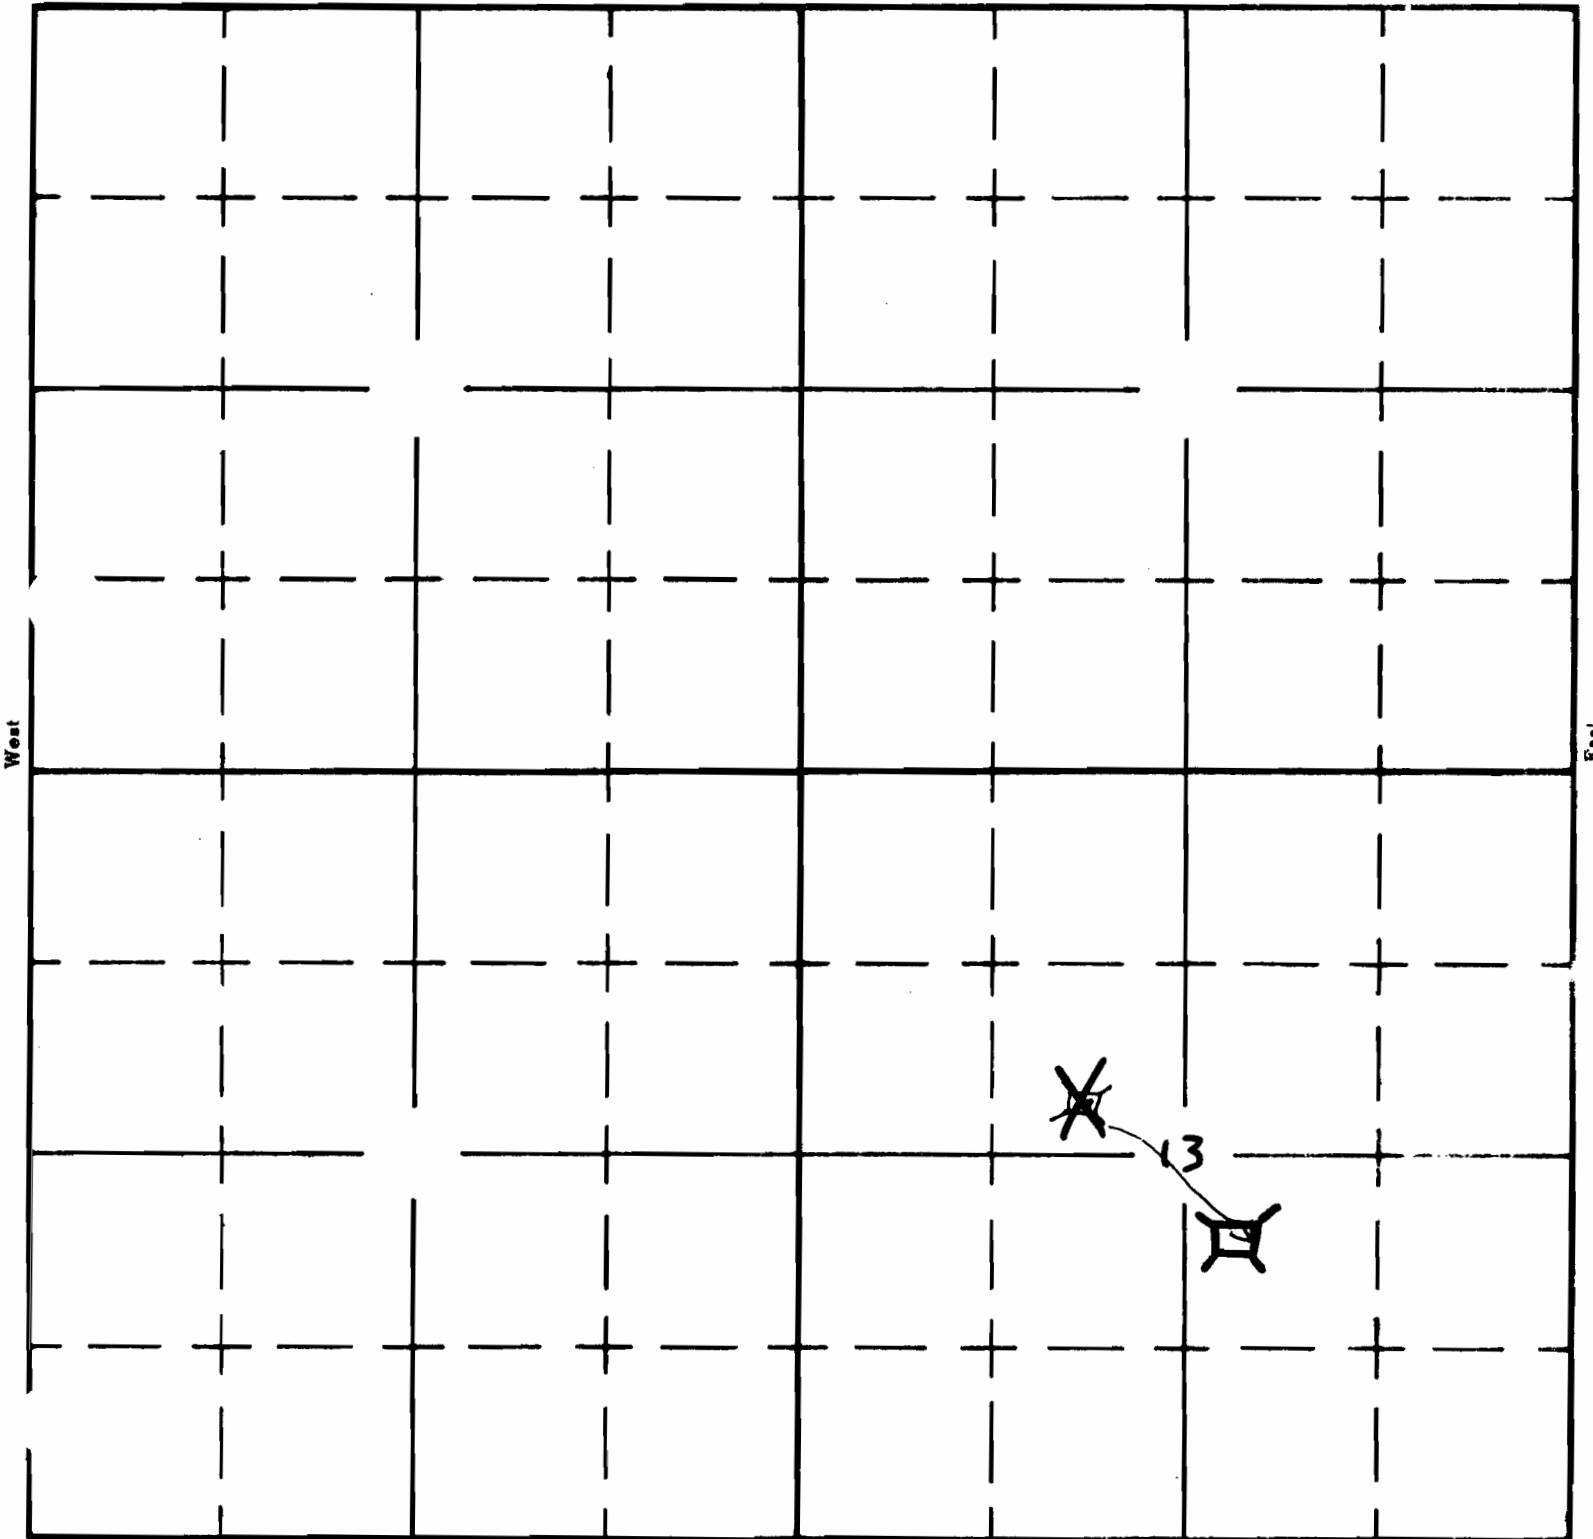

Application No. R-34259
Permit No. R-2497

APPLICATION No.
PERMIT No.