


UNITED STATES
DEPARTMENT OF THE INTERIOR
BUREAU OF LAND MANAGEMENT

SECTION

25
NE $\frac{1}{4}$ NW $\frac{1}{4}$

Oregon State Water Filings

TOWNSHIP 30 S, RANGE 32 E, W. M.

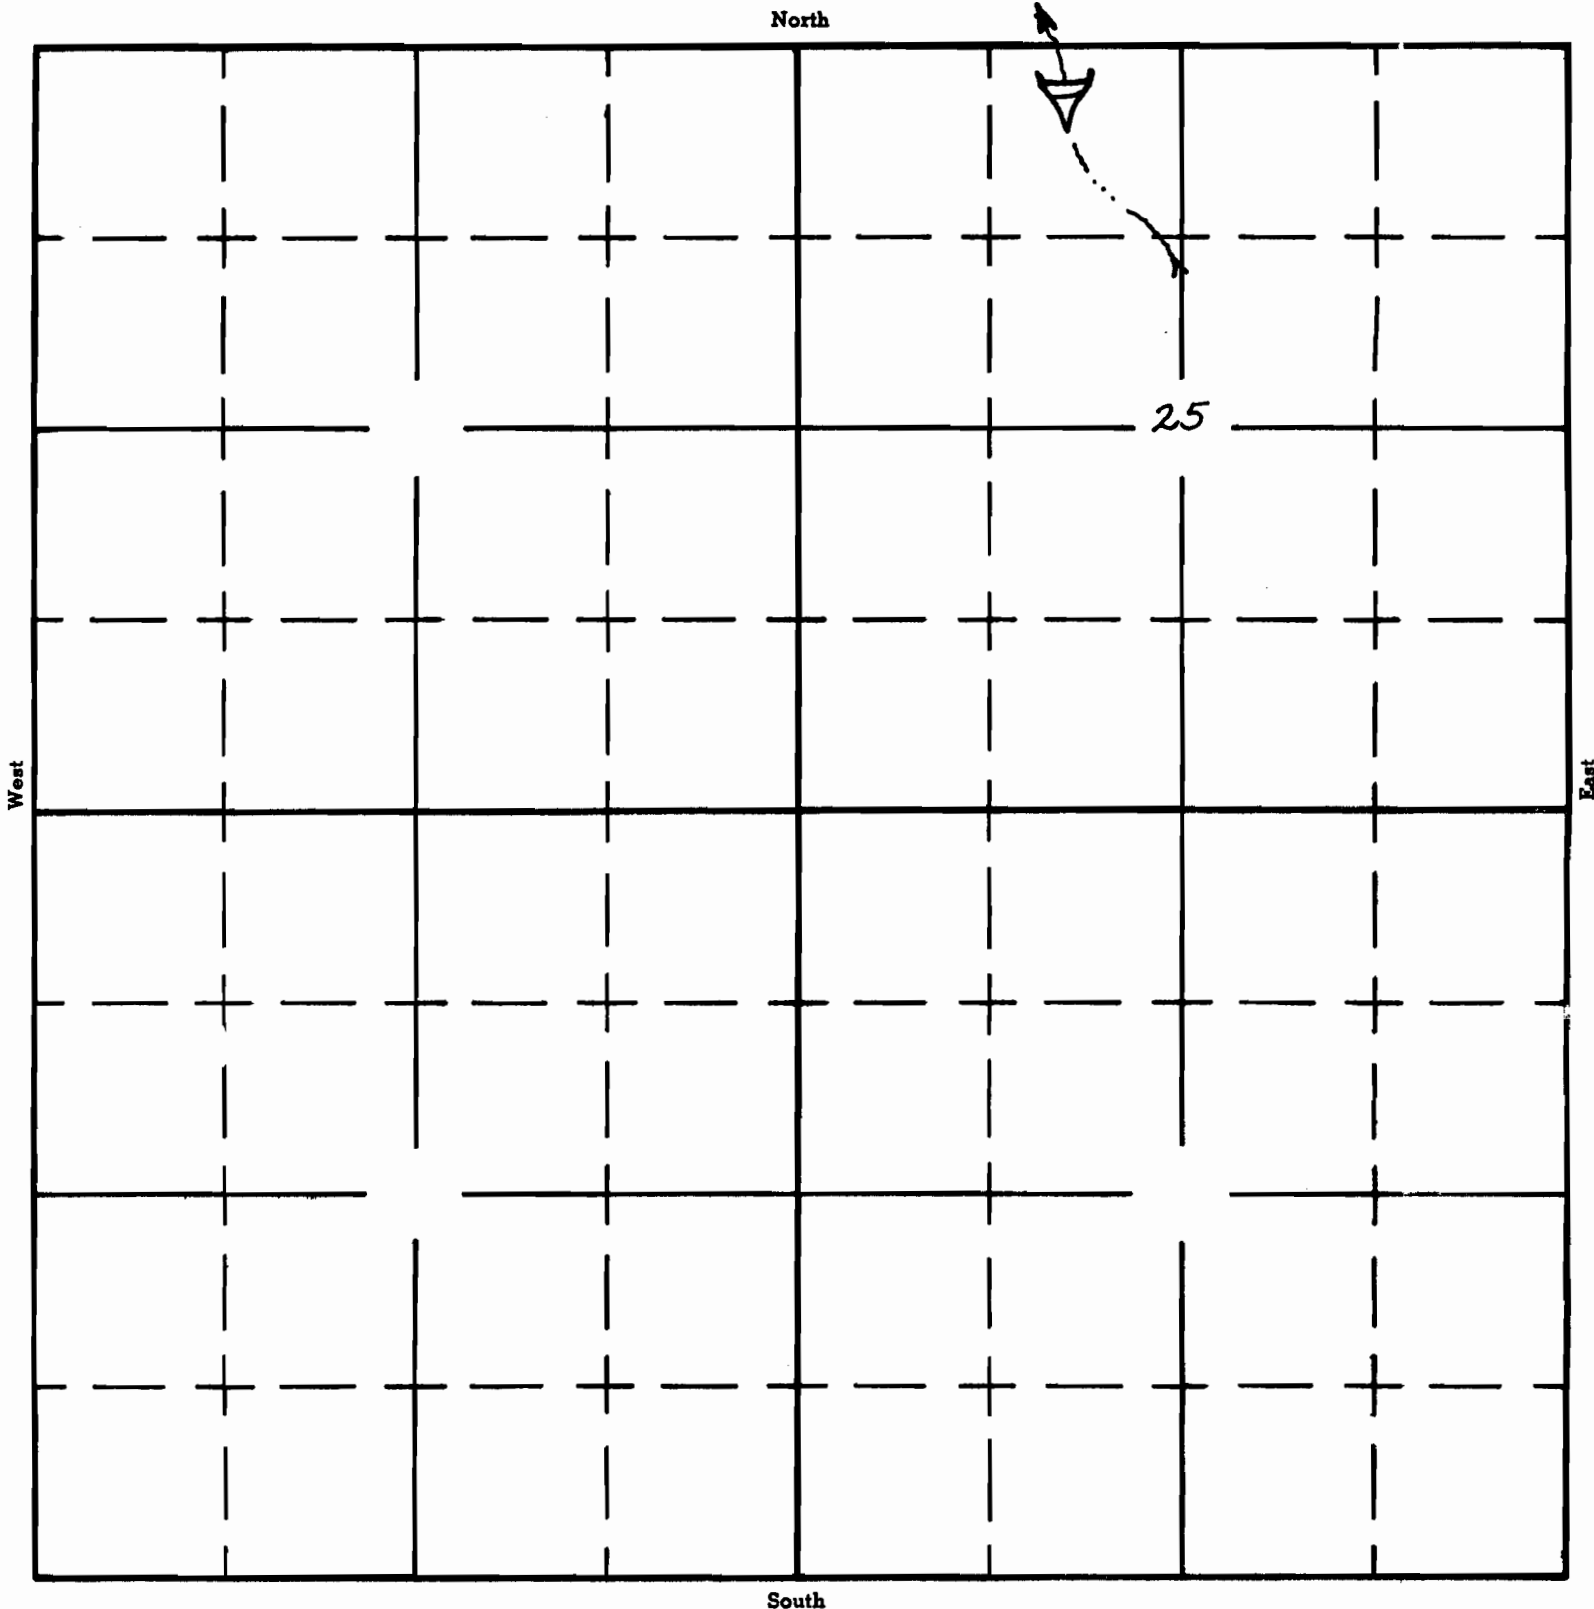

APPLICATION No. R34895

PERMIT No. R-2751