

UNITED STATES
DEPARTMENT OF THE INTERIOR
BUREAU OF LAND MANAGEMENT

SECTION


23

SE $\frac{1}{4}$ NE $\frac{1}{4}$

Oregon State Water Filings

TOWNSHIP 30 S, RANGE 32 E, W. M.

North

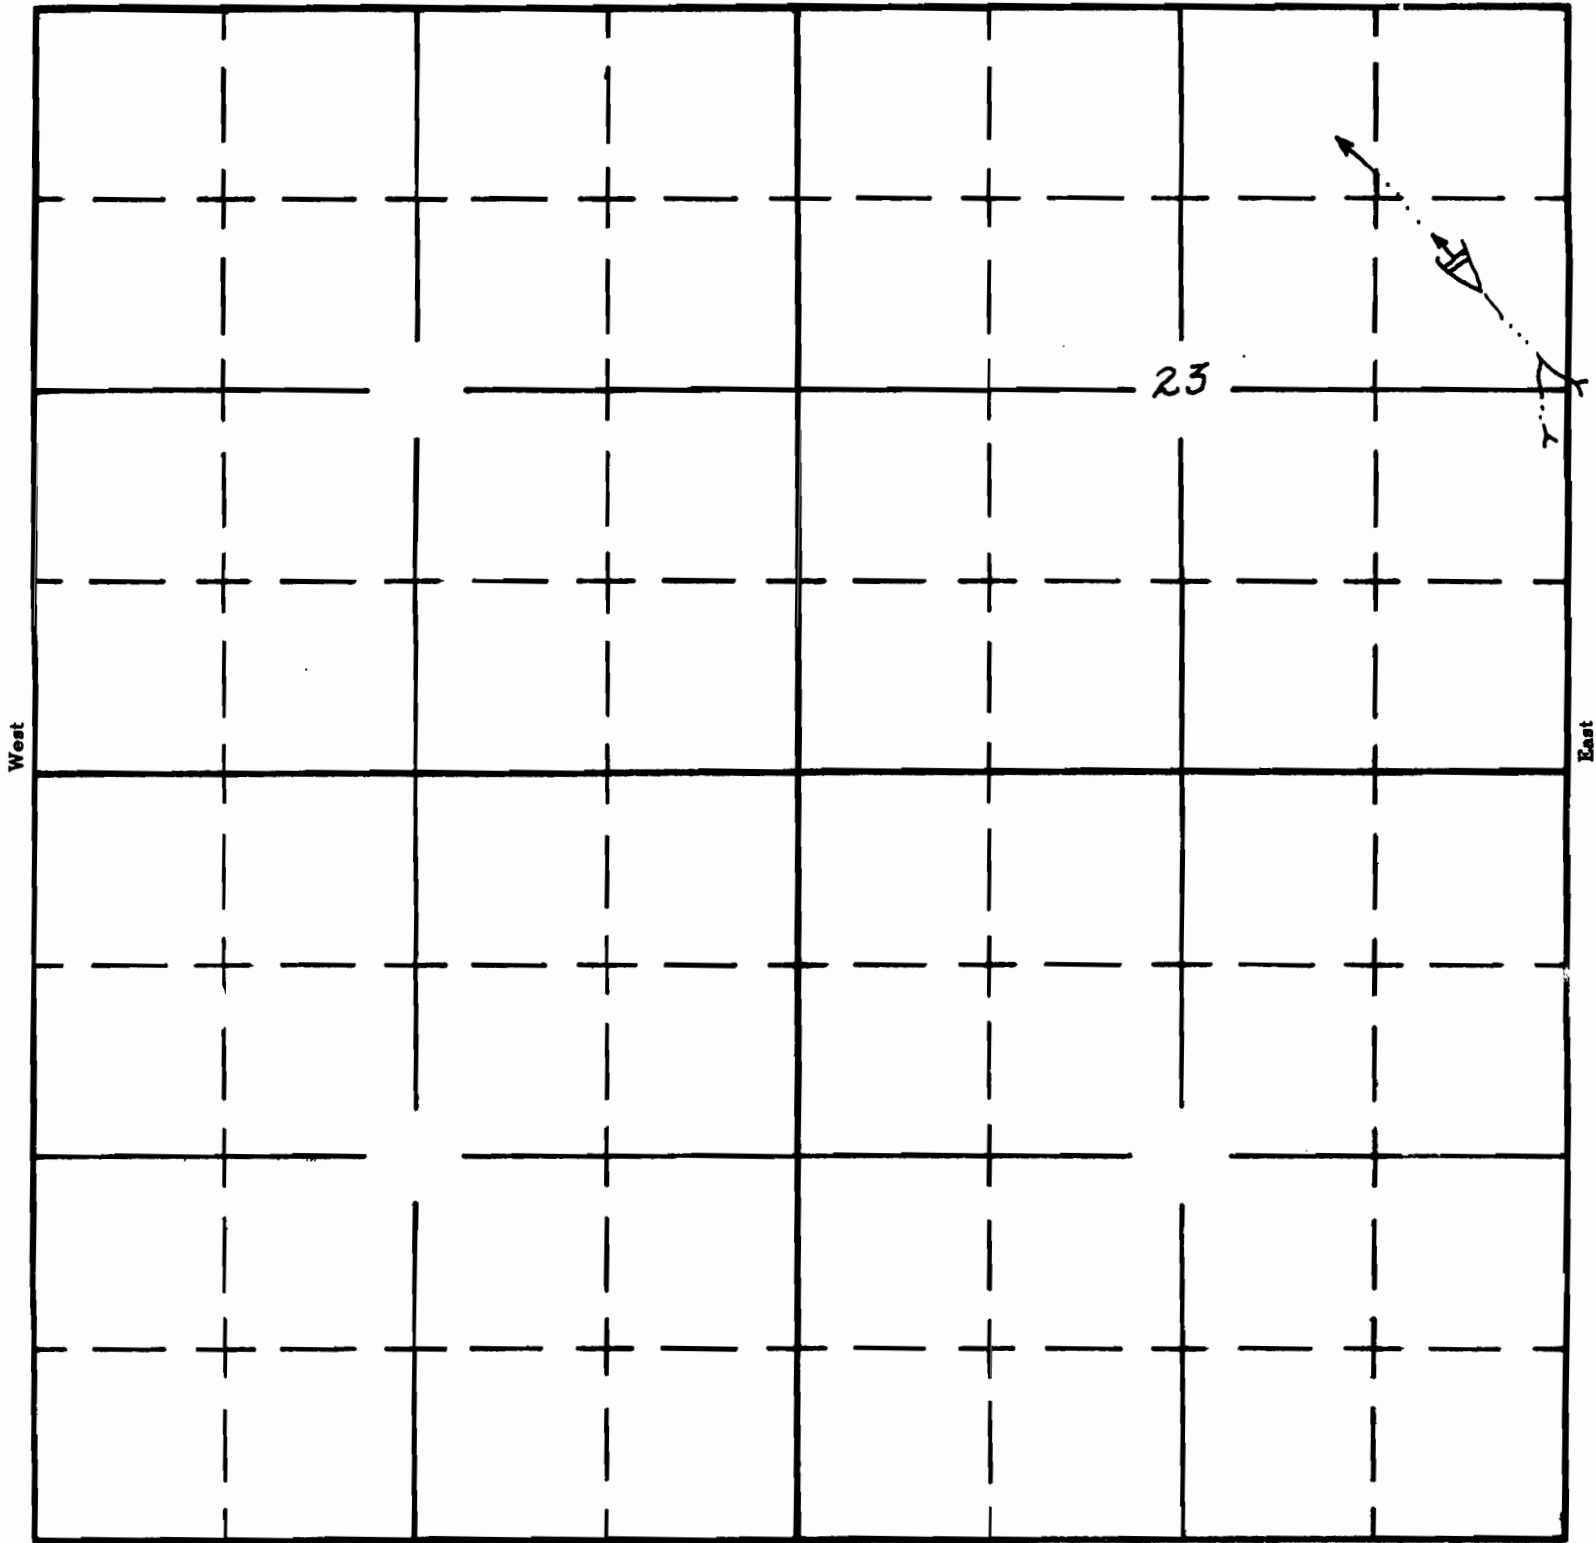

South

APPLICATION No. R-34899

PERMIT No. R-2755