

Form A1-187
March 1961

UNITED STATES
DEPARTMENT OF THE INTERIOR
BUREAU OF LAND MANAGEMENT

SECTION


SE $\frac{1}{4}$ SE $\frac{1}{4}$

Oregon State Water Filings

SEC. 1

TOWNSHIP 32S, RANGE 32 $\frac{1}{2}$ E, W. M.

North

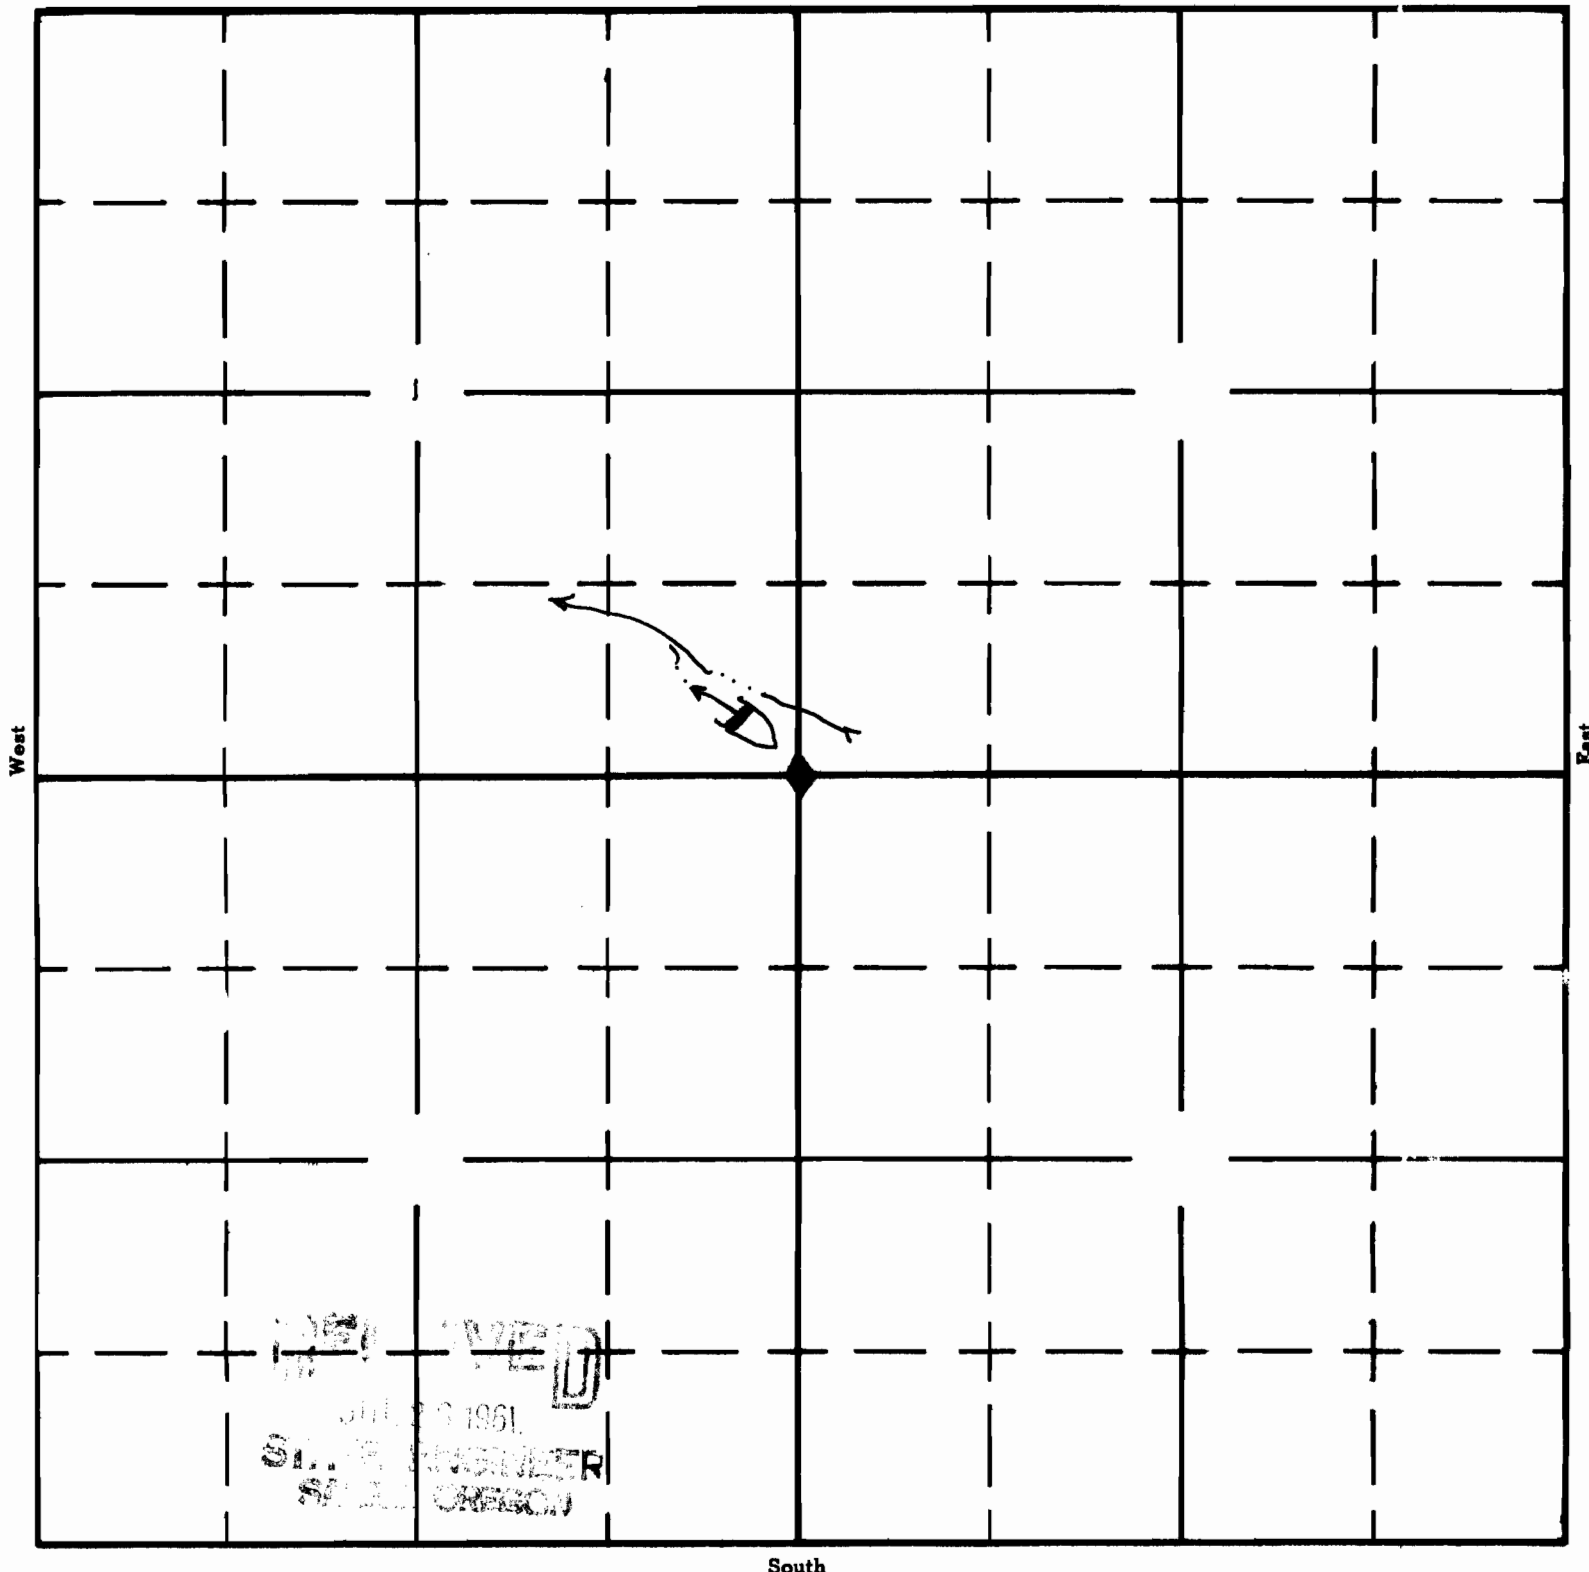

RECEIVED
JUL 26 1961

South

APPLICATION No. R-35541
PERMIT No. R-2804