

Form AI-187
March 1961

UNITED STATES
DEPARTMENT OF THE INTERIOR
BUREAU OF LAND MANAGEMENT

SECTION


SE $\frac{1}{4}$ NW $\frac{1}{4}$

SEC 19

Oregon State Water Filings

TOWNSHIP 37 S, RANGE 32 $\frac{3}{4}$ E, W. M.

North

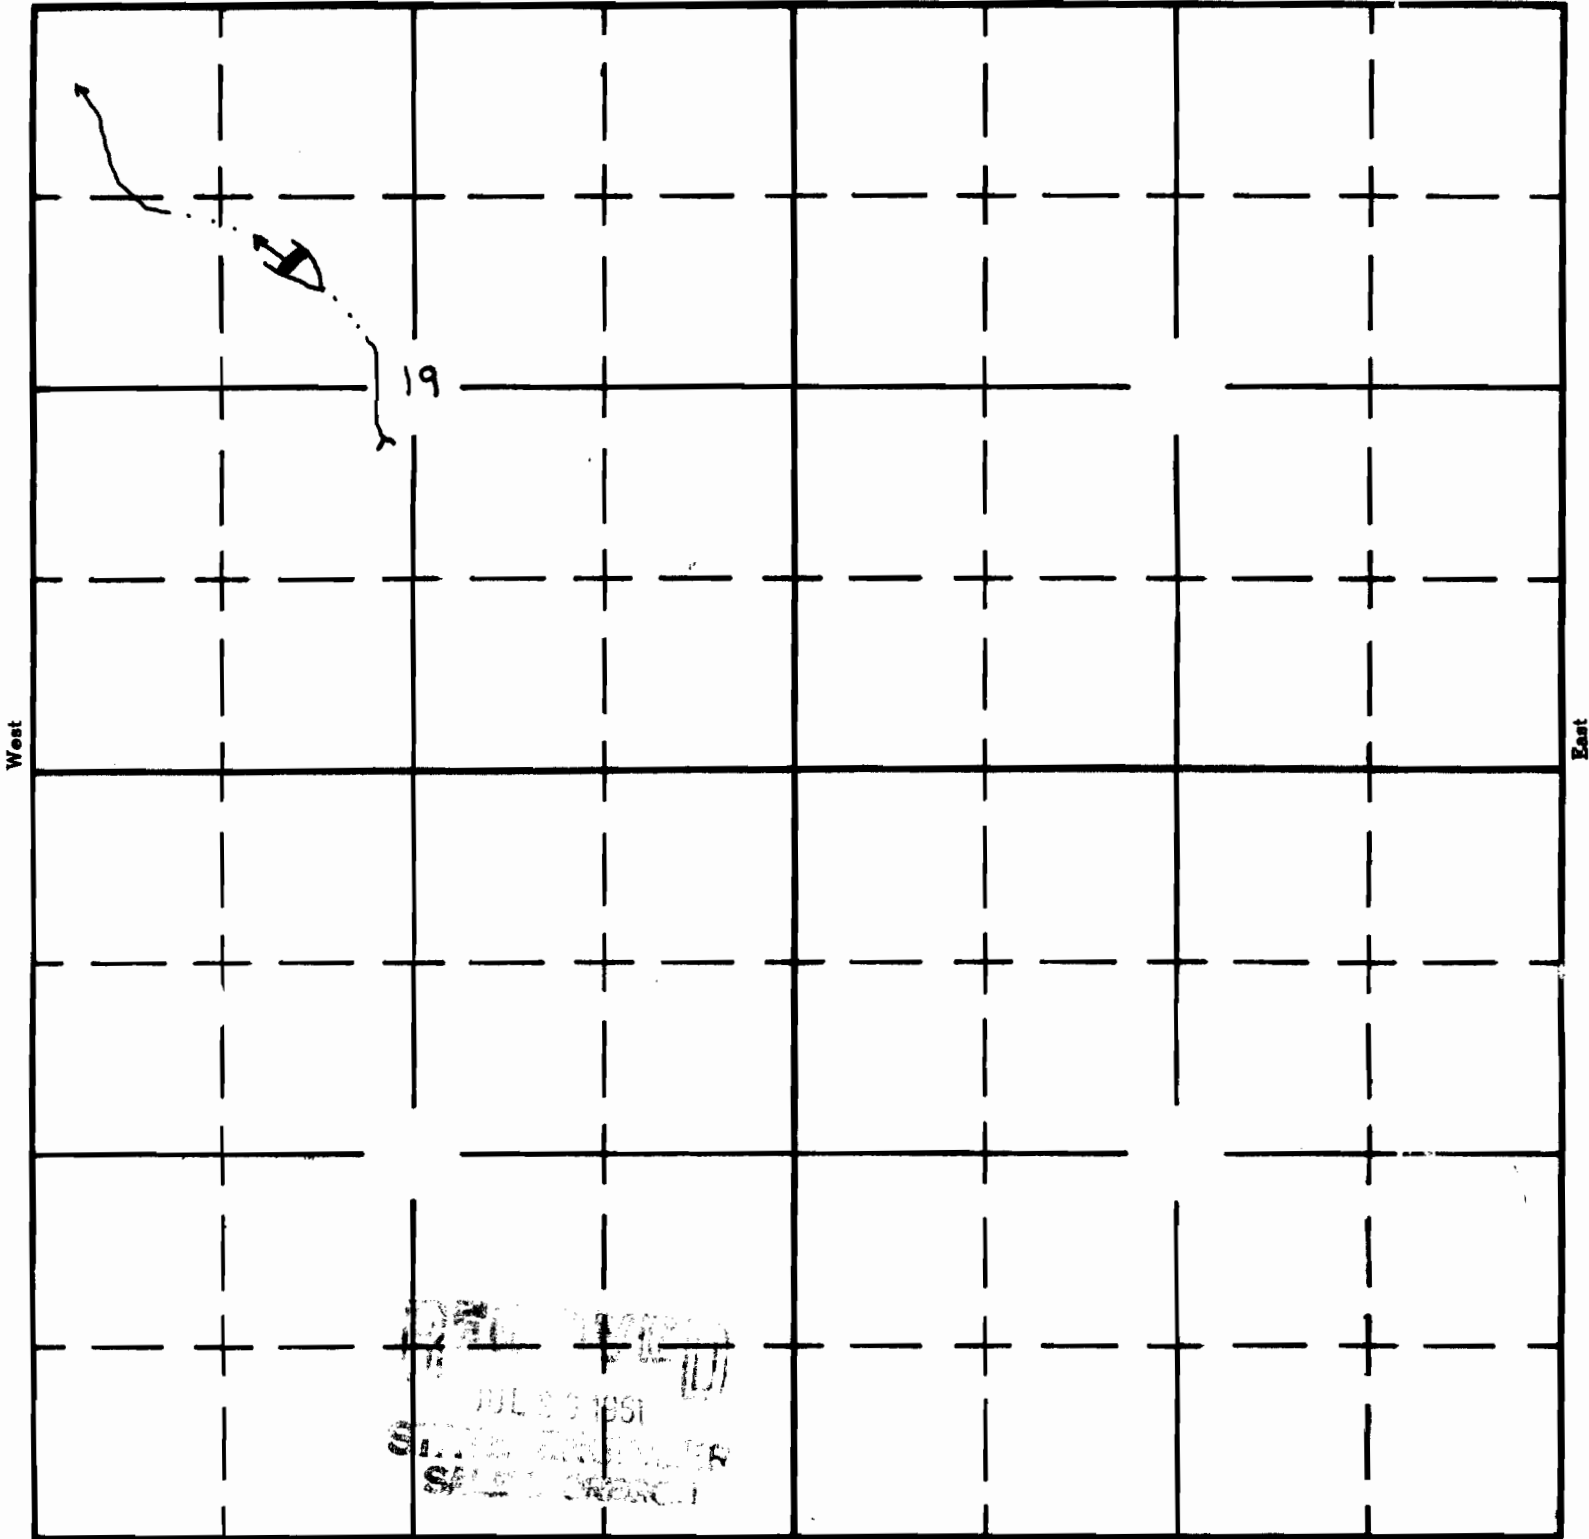

JUL 29 1961
STATE ENGINEER

South

APPLICATION No. R-35544

PERMIT No. R-2987