

Form AI-187
March 1961


UNITED STATES
DEPARTMENT OF THE INTERIOR
BUREAU OF LAND MANAGEMENT

SECTION
NE $\frac{1}{4}$ SW $\frac{1}{4}$
Sec. 23

Oregon State Water Filings

TOWNSHIP 37S, RANGE 32E, W. M.

North

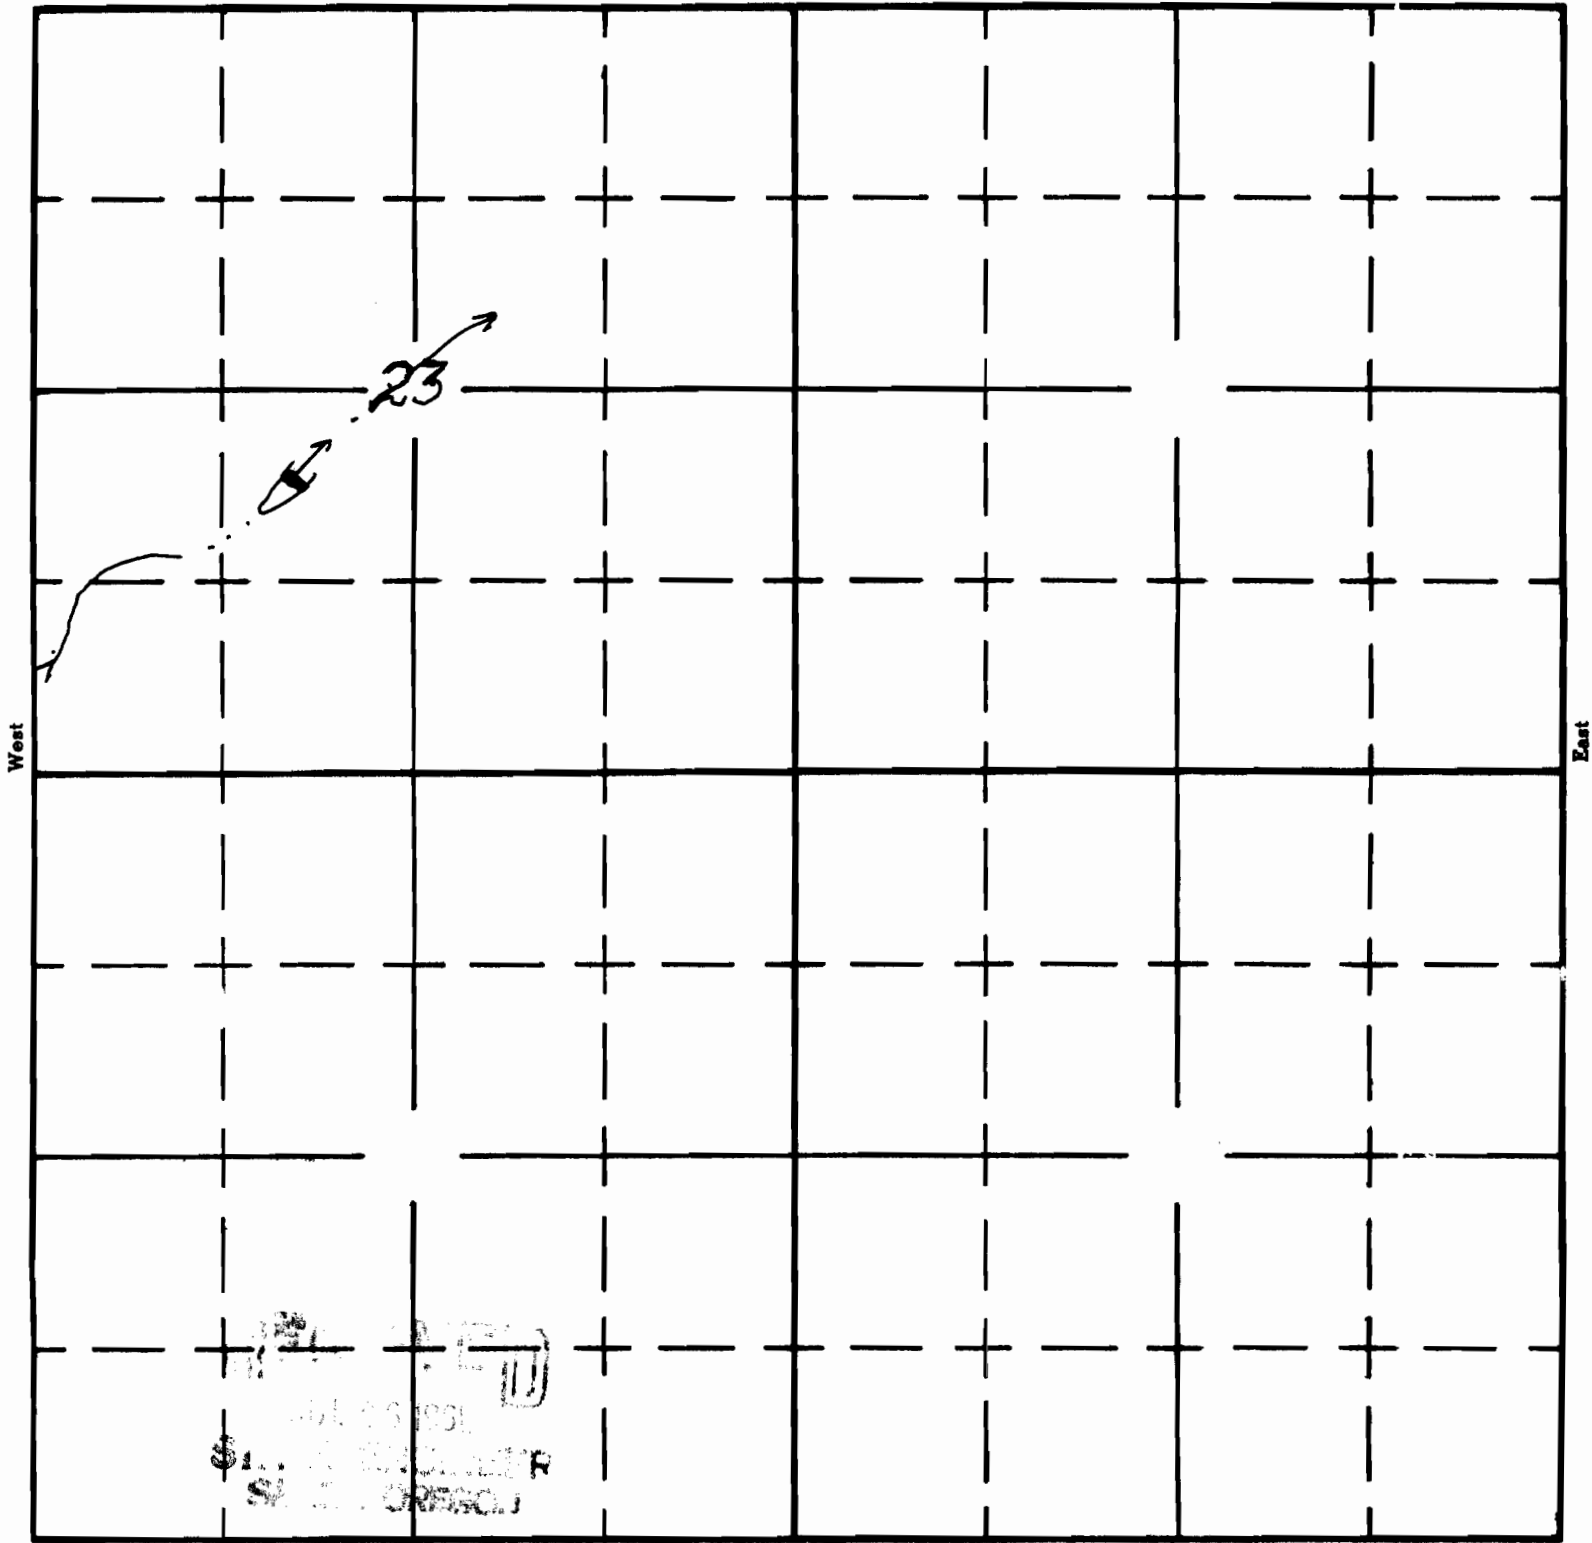

South

APPLICATION No. A-35546
PERMIT No. A-2889