

Form AI-187
March 1961

UNITED STATES
DEPARTMENT OF THE INTERIOR
BUREAU OF LAND MANAGEMENT

SECTION

SE 1/4 NE 1/4

Oregon State Water Filings

SEC 33

TOWNSHIP 37 S, RANGE 32 1/2 E, W. M.

North

33



RECEIVED
JUL 30 1961
STATE ENGINEER
SALEM, OREGON

South

APPLICATION No. R-35551

PERMIT No. R-2894

Form AI-187
March 1961

UNITED STATES
DEPARTMENT OF THE INTERIOR
BUREAU OF LAND MANAGEMENT

SECTION


31

SE 1/4 NE 1/4

Oregon State Water Filings

TOWNSHIP 32 S, RANGE 29 E, W. M.

North *Tied in with aerial photo and ASHU quad maps.*

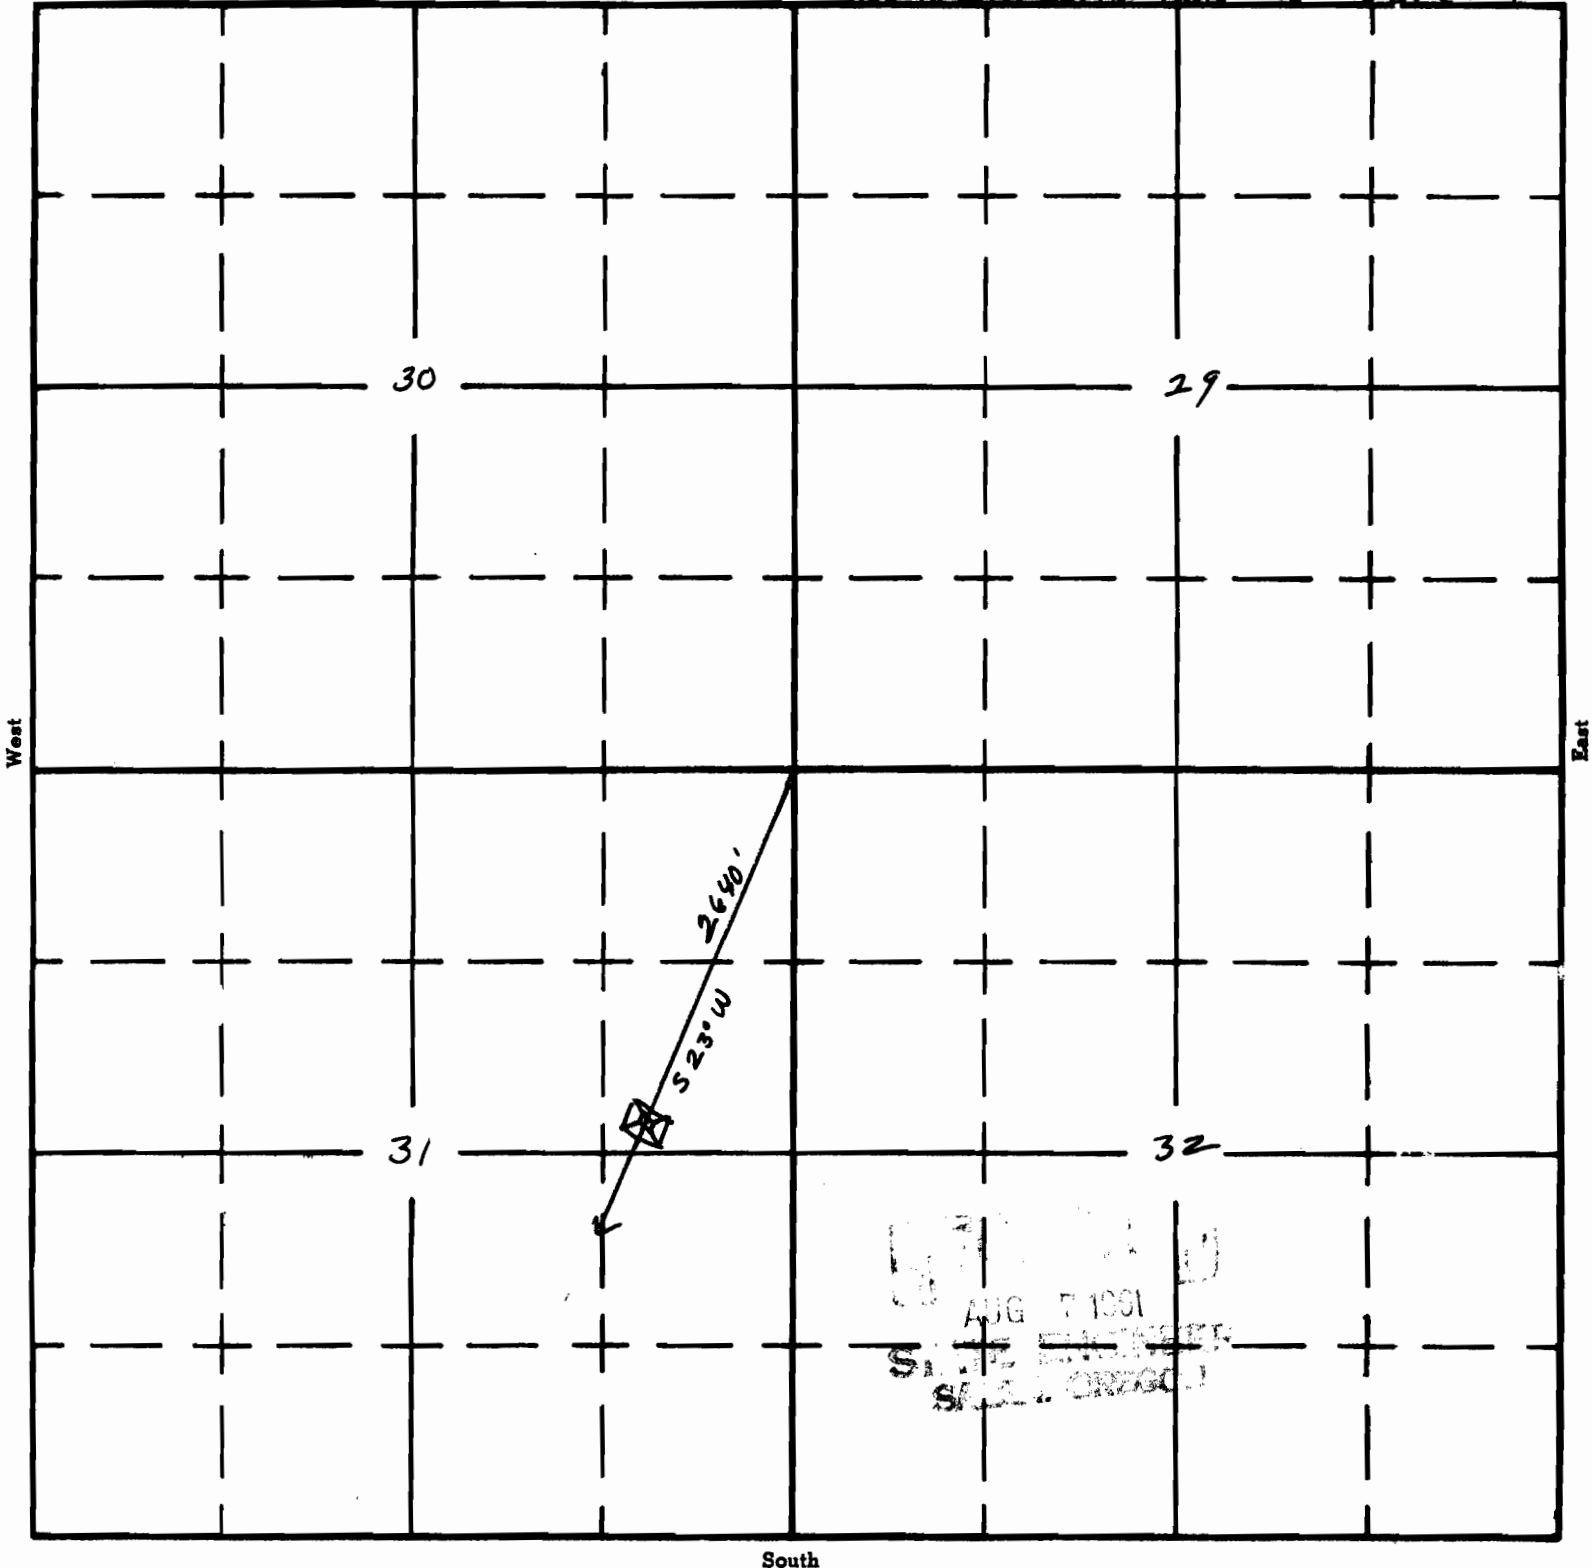

APPLICATION No. R-36236

PERMIT No. R-4083